

SURVEY & REMONUMENTATION

CHIPPEWA COUNTY REMONUMENTATION CORNER

APR 27 1995

LAND CORNER RECORDATION CERTIFICATE


Filing Requirement of Act 74, Mich. P.A. 1970

For corners in Chippewa **COMMISSION**
(County)

	Located in:	Corner Code #
1. Public Land Survey	T <u>46N</u> R <u>1W</u>	F-7
	T _____ R _____	_____
	T _____ R _____	_____
	T _____ R _____	_____
2. Property Controlling in Section	S _____ T _____ R _____	_____
	S _____ T _____ R _____	_____
3. Miscellaneous Property in Sec.	S _____ T _____ R _____	_____
	S _____ T _____ R _____	_____
4. Lot No. _____, Recorded Plat _____		
5. Private Claims _____		

\$ 7.00 LAND CORNER
\$ 2.00 MSSR
19 DEC 94 10:17 A.M. RECEIPT# 1769
RECEIVED FOR RECORD
CHIPPEWA COUNTY - STATE OF MICHIGAN
SHARON H. KENNEDY, REGISTER OF DEEDS
Register of Deeds Stamp & File Number

I, William L. Karr in a field survey on October 19, 1994, do hereby certify that under requirements of P.A. 74, Michigan P.A. of 1970, the corner points mentioned in lines 1 and 2 above were in conformance with regulations and rules therefore as required in the current manual of survey instructions of the United States Department of the Interior, Bureau of Land Management or by a decree of a Court of Law and/or that the corner points mentioned in lines 3, 4 and 5 above were in conformance with the rules of the Michigan Board of Land Surveyors or by a Decree of a Court of Law; established, re-established, monumented, re-monumented, recovered, found as expressed below:

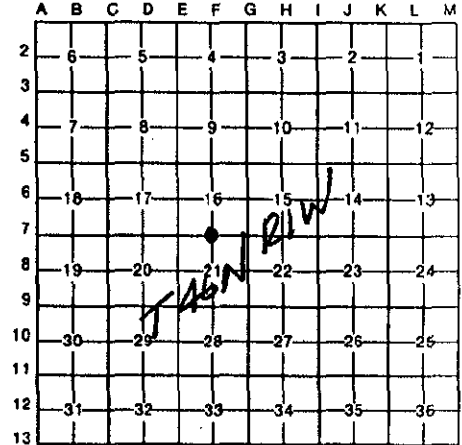

NOTE: Not more than 4 corners, all in the same town and range, may be recorded on this certificate.

A. Description of original monument and accessories and/or subsequent restoration:


(F-7) 1/4 Corner common to Sections 16 & 21, T.46 N., R.1 W.

1845: J. Mullett set 1/4 section post. Fir 10 S81E 11 lks Fir 8 N19W 16 lks
? County Surveyor notes from the early 1900's show an overall distance for the Section line as 5264' with an even split for the 1/4 corner, (2632' for each 1/2 mile).

B. Description of corner evidence found and/or method applied in restoring or reestablishing corner:

(F-7) This corner is being re-established as part of the Chippewa County Remonumentation program.

Found no evidence of original corner. Re-established corner on line between the Section corner 16, 17, 20 & 21 to the West and Section corner 15, 16, 21 & 22 to the East on the extension of 1/4 lines fences to the North and South. Distance from the re-established corner to the East is 2630.28' and to the West is 2633.05'.

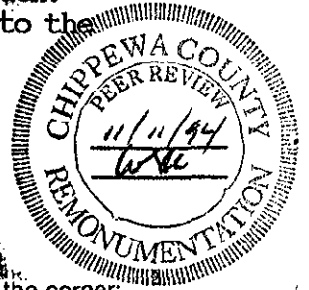

C. Description of monument for corner and accessories established to perpetuate locating the position of the corner:

(F-7) Corner is a 3/4"x 24" iron with plastic "Chippewa County Remonumentation" cap, 9.8' North of the centerline of M-28 and on the extension of fencelines to the North and South.

Witnesses: 2nd Post East of Fence Corner N20°E 63.54'
P. Pole S50°E 101.46'
12" Jack Pine S06°W 67.62'
3rd Post North of Fence Corner North 77.51'



Signed by William L. Karr Date 12/7/94
Surveyor's Michigan License No. 27450 723-12

NOTE: Bearings are compass bearings corrected for declination. Distances are to a nail in side of witness objects unless noted.