

MAY 28 1997

COMMISSION **CHIPPEWA COUNTY REMONUMENTATION CORNER**

LAND CORNER RECORDATION CERTIFICATE
Filing Requirement of Act 74, Mich. P.A. 1970

For corners in

Chippewa (County)	Located In:	Corner Code #
1. Public Land Survey	T46N R 1W	F-9
	T ___ R ___	___
	T ___ R ___	___
	T ___ R ___	___
2. Property Controlling in Section	S ___ T ___ R ___	___
	S ___ T ___ R ___	___
3. Miscellaneous Property in Sec.	S ___ T ___ R ___	___
	S ___ T ___ R ___	___

BOOK **10** PAGE **17**

\$7.00 RECORDING FEE

\$2.00 HSSR

3/3/1997 5:06:59 PM Receipt #275
RECEIVED FOR RECORD
CHIPPEWA COUNTY - STATE OF MICHIGAN
SHARON H. KENNEDY, REGISTER OF DEEDS

BOOK **10** PAGE **17**
Register of Deeds Stamp & File Number

4. Lot No. _____, Recorded Plat _____
5. Private Claims _____

I, Keith R. Waters, in a field survey on 12/19, 1996 do hereby state that under requirements of P.A. 74, Michigan P.A. of 1970, the corner points mentioned in lines 1 and 2 above were in conformance with regulations and rules therefore as required in the current manual of survey instructions of the United States Department of the Interior, Bureau of Land Management or by a decree of a Court of Law and /or that the corner points mentioned in lines 3, 4 and 5 above were in conformance with the rules of the Michigan Board of Land Surveyors or by a Decree of a Court of Law; established, re-established, monumented, recovered, found as expressed below:

NOTE: Not more than 2 corners, all in the same town and range, may be recorded on this certificate.

A	B	C	D	E	F	G	H	I	J	K	L	M
1												
2	6	5	4	3	2	1						
3												
4	7	8	9	10	11	12						
5												
6	18	17	16	15	14	13						
7												
8	19	20	21	22	23	24						
9												
10	30	29	28	27	26	25						
11												
12	31	32	33	34	35	36						
13												

A. Description of original monument and accessories and/or subsequent restoration:

- F-9 1/4 Corner Common to Sections 21 & 28, Town 46 North, Range 1 West
- 1845 - Original corner (James Mullett) was a 15" Hemlock.
- 1903 - County Surveyor Frederick H. Brown indicates "an original corner, cedar post." Corner is shown midway between section corners 2621 feet east and west.
- 1977 - James H. Granger, P.S. 16041, liber 1, page 273, Chippewa County corner records. Found 1/2" iron pipe N 1/4 corner Section 28.
- 1984 - James F. Fletcher, P.S. 19830, unrecorded LCRC. Found 1/2" steel bar in approximate centerline of county road.
- 1991 - Larry R. Rogers, P.S. 29251, liber 7, page 382, Chippewa County corner records. Replaced found bent 3/4" iron with 1/2" iron and cap #29251. Witnesses: 12" Scotch Pine, N34°W 50.05' - 8" Spruce, S04°E 50.25' - Power Pole (A1-44), N46°E 47.19' - 8" Apple, S43°E 38.06'.


B. Description of corner evidence found and/or method applied in restoring or reestablishing corner:

This corner is being perpetuated as part of the Chippewa County Remonumentation Program. Found a 1/2" iron with cap #29251 and all witness objects as described in LCRC liber 7, page 382. The distance to section corner east is within 0.7 feet of above mentioned County Surveyor notes, distance to section corner west is within 2.2 feet of said notes.

C. Description of monument for corner and accessories established to perpetuate locating the position of the corner:

- Corner is a 1/2" iron with cap #29251 in the approximate centerline of east-west asphalt road (10 Mile Road).
- Witnesses:
- 12" Scotch Pine, N34°W 50.05' (large nail in side)
- 8" Spruce, S04°E 50.25' (large nail in side)
- Power Pole (A1-44), N46°E 47.19' (large nail in side)
- 8" Apple, S43°E 38.06' (nail and tag #29251 in side)

Note: Bearings are compass bearings corrected for declination.

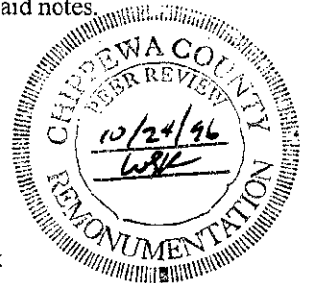

Signed by Keith R. Waters
Surveyor's Michigan License No. 33142

Date 12-30-96
BOOK **10** PAGE **17**