

MAY 28 1997

COMMISSIONER CHIPPEWA COUNTY REMONUMENTATION CORNER

LAND CORNER RECORDATION CERTIFICATE
Filing Requirement of Act 74, Mich. P.A. 1970

For corners in

Chippewa (County)	Located In:	Corner Code #
1. Public Land Survey	T46N R 1W	F-11
	T R	
	T R	
	T R	
2. Property Controlling in Section	S T R	
	S T R	
3. Miscellaneous Property in Sec.	S T R	
	S T R	

\$7.00 RECORDING FEE

\$2.00 MSSR

3/3/1997 5:07:25 PM Receipt #275
RECEIVED FOR RECORD
CHIPPEWA COUNTY - STATE OF MICHIGAN
SHARON H. KENNEDY, REGISTER OF DEEDS

BOOK 10 PAGE 18
Register of Deeds Stamp & File Number

4. Lot No. _____, Recorded Plat _____
5. Private Claims _____

I, Keith R. Waters, in a field survey on 05/20, 1996 do hereby state that under requirements of P.A. 74, Michigan P.A. of 1970, the corner points mentioned in lines 1 and 2 above were in conformance with regulations and rules therefore as required in the current manual of survey instructions of the United States Department of the Interior, Bureau of Land Management or by a decree of a Court of Law and /or that the corner points mentioned in lines 3, 4 and 5 above were in conformance with the rules of the Michigan Board of Land Surveyors or by a Decree of a Court of Law; established, re-established, monumented, recovered, found as expressed below.

NOTE: Not more than 2 corners, all in the same town and range, may be recorded on this certificate.


	A	B	C	D	E	F	G	H	I	J	K	L	M
1													
2	6		5		4		3		2		1		
3													
4	7		8		9		10		11		12		
5													
6	16		17		16		15		14		13		
7													
8	19		20		21		22		23		24		
9													
10	30		29		28		27		26		25		
11													
12	31		32		33		34		35		36		
13													

A. Description of original monument and accessories and/or subsequent restoration:

F-11 1/4 Corner Common to Sections 28 & 33, Town 46 North, Range 1 West
1845 - Original ties (James Mullett): Fir 6, S05°W 11 links - Fir 12, N09°E 32 links.
1891, 1898 - County Surveyor Frederick H. Brown notes show this corner midway between section corners 2632 feet east and west.
1903 - County Surveyor Frederick H. Brown notes say "all burned, corner gone, cedar post." Distances to section corners east and west is shown as 2634 feet.
1977 - James H. Granger, P.S. 16041, LCRC in liber 1, page 274, Chippewa County corner records. Found 1" iron pin.
Witnesses: 16" Spruce, N27°W 36.55' - 5" Spruce, S49°W 43.52' - 16" Spruce, N52°W 33.30.

B. Description of corner evidence found and/or method applied in restoring or reestablishing corner:

This corner is being perpetuated as part of the Chippewa County Remonumentation Program.
Found a 1 1/4" iron pin 3 feet north of the approximate centerline of east-west gravel road. Also found one spruce bearing tree as called for in LCRC liber 1, page 274 and the rotted stump of another spruce. Corner is 2631.35 feet from section corner west, 2630.71 from section corner east, and is 0.6 feet north of a straight line between said section corners.
Accepted corner as found and established new witness objects.

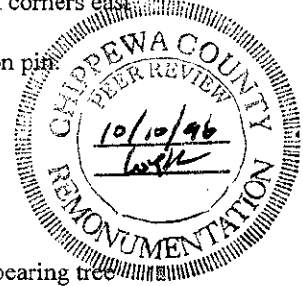

C. Description of monument for corner and accessories established to perpetuate locating the position of the corner:

Corner is a 1 1/4" iron pin approximately 3 feet north of the centerline of 11 Mile Road (gravel).
Witnesses:
Nail and Tag #24599 in Rotted Stump, N59°W 33.30'
Power Pole (DR4-39-42), N59°W 43.62'
14" Spruce, S43°W 44.02' (not blazed)
5" Spruce, N24°W 46.86'
9" Elm, S79°E 214.62'



Note: Unless noted otherwise, distances are to a nail/tag #33142 in the side of the witness object. Bearings are compass bearings corrected for declination. 5" Spruce and 9" Elm are blazed and painted.

Signed by Keith R. Waters
Surveyor's Michigan License No. 33142

Date 12-30-96

BOOK 10 PAGE 18