

MAY 28 1997

COMMISSIONER CHIPPEWA COUNTY REMONUMENTATION CORNER

LAND CORNER RECORDATION CERTIFICATE  
Filing Requirement of Act 74, Mich. P.A. 1970

For corners in

Chippewa

(County)

Located In:

Corner Code #

1. Public Land Survey

T46N R 1W

G-3

2. Property Controlling  
in Section

S  
S  
S  
S

T  
T  
T  
T


3. Miscellaneous  
Property in Sec.

S  
S

T  
T

4. Lot No. \_\_\_\_\_, Recorded Plat \_\_\_\_\_

5. Private Claims \_\_\_\_\_

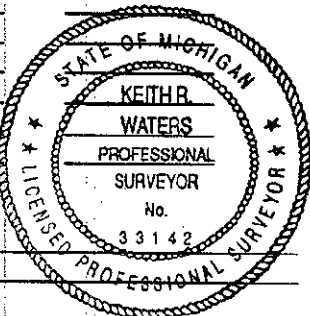

\$7.00 RECORDING FEE

\$2.00 MSSR

3/3/1997 5:08:21 PM Receipt #275

RECEIVED FOR RECORD

CHIPPEWA COUNTY - STATE OF MICHIGAN  
SHARON H. KENNEDY, REGISTER OF DEEDS

BOOK 10 PAGE 20

Register of Deeds Stamp & File Number

I, Keith R. Waters, in a field survey on 08/08, 1996 do hereby state that under requirements of P.A. 74, Michigan P.A. of 1970, the corner points mentioned in lines 1 and 2 above were in conformance with regulations and rules therefore as required in the current manual of survey instructions of the United States Department of the Interior, Bureau of Land Management or by a decree of a Court of Law and /or that the corner points mentioned in lines 3, 4 and 5 above were in conformance with the rules of the Michigan Board of Land Surveyors or by a Decree of a Court of Law; established, re-established, monumented, recovered, found as expressed below:

NOTE: Not more than 2 corners, all in the same town and range, may be recorded on this certificate.

	A	B	C	D	E	F	G	H	I	J	K	L	M
1													
2	6		5		4		3		2		1		
3							●						
4	7		8		9		10		11		12		
5													
6	16		17		16		15		14		13		
7													
8	19		20		21		22		23		24		
9													
10	30		29		28		27		26		25		
11													
12	31		32		33		34		35		36		
13													

A. Description of original monument and accessories and/or subsequent restoration:

G-3 Corner Common to Sections 3, 4, 9, & 10, Town 46 North, Range 1 West

1845 - Original ties (James Mullett): White Pine 20, S85°E 36 links - Birch 10, S39°W 11 links.

1890 - County Surveyor Frederick H. Brown notes indicate that he pro-rated this corner between the original 1/4 post at G-4 and the corner G-1 on the township line to the north. Brown's sketch shows a distance of 5679 feet between G-1 and G-3.

1892 - Brown again indicates a proration as mentioned above. This distance between G-1 and G-3 is shown as 5684 feet.

(Various subsequent notes by Brown show the distance between G-3 and G-4 as both 2705 feet and 2804 feet. It appears that Brown made an error of 100 feet in chaining between G-1 and G-4 when he pro-rated the corner).

Circa 1920's - County Surveyor notes show this corner 74 feet east of the easterly railroad rail.

Other witnesses: Look Out Sign, N67°W 64' - Pole, S51°30'W 52'.

B. Description of corner evidence found and/or method applied in restoring or reestablishing corner:

This corner is being perpetuated as part of the Chippewa County Remonumentation Program.

Found a 4" diameter concrete monument on the south edge of an east-west gravel road. Also found the remains of a utility pole southwest 52 feet as noted in above mentioned County Surveyor notes. The distance to corner G-1 on the town line to the north is 5683.37 feet, which checks well with Brown's notes. The overall distance between G-1 and G-4 is approximately 100 feet shorter than Brown notes. This results in the distance between G-3 and G-4 being about 100 feet shorter than the distance between G-2 and G-3, which is reflected in Brown's notes. I believe that the found monument occupies the position as established by Brown and accept the corner position as found.

C. Description of monument for corner and accessories established to perpetuate locating the position of the corner:

Corner is a 4" diameter concrete monument on the south edge of an east-west gravel road (7 Mile Road), on the east side of the north-south railroad tracks, which are on the east side of the Soo Line Road. Witnesses:

26" Poplar, S33°W 44.28' (N'y tree in row of about 2 dozen)


Power Pole (E-20), S73°W 135.19'

Power Pole (E-2003), N86°E 190.60'

MBT Pole (40B3), N46°W 32.32'

Center of Easterly Railroad Rail, WEST 73.30'

Note: Unless noted otherwise, distances are to a nail and tag in the side of the witness object. Bearings are compass bearings corrected for declination.

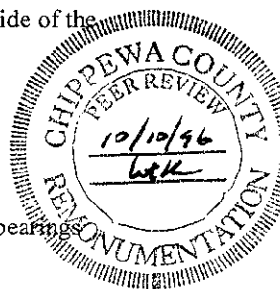

Signed by Keith R. Waters

Date 12-30-96

Surveyor's Michigan License No. 33142

BOOK 10 PAGE 20