

MAY 28 1997

COMMISSION

CHIPPEWA COUNTY REMONUMENTATION CORNER

LAND CORNER RECORDATION CERTIFICATE
Filing Requirement of Act 74, Mich. P.A. 1970

BOOK 10 PAGE 21

For corners in

Chippewa
(County)


Located In:

Corner Code #

- 1. Public Land Survey
- 2. Property Controlling in Section
- 3. Miscellaneous Property in Sec.

T46N R 1W
 T ___ R ___
 T ___ R ___
 T ___ R ___
 S ___ T ___ R ___
 S ___ T ___ R ___
 S ___ T ___ R ___
 S ___ T ___ R ___

G-4

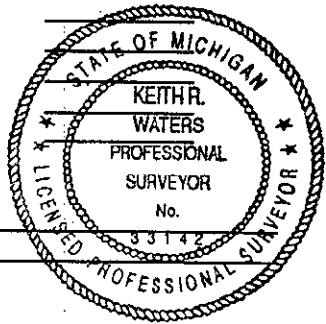

\$7.00 RECORDING FEE
\$2.00 MSSR

3/3/1997 5:08:39 PM Receipt #2
RECEIVED FOR RECORD
CHIPPEWA COUNTY - STATE OF MICHIGAN
SHARON H. KENNEDY, REGISTER OF DEEDS

Register of Deeds Stamp & File Number

- 4. Lot No. _____, Recorded Plat _____
- 5. Private Claims _____

I, Keith R. Waters, in a field survey on 11/18, 1996 do hereby state that under requirements of P.A. 74, Michigan P.A. of 1970, the corner points mentioned in lines 1 and 2 above were in conformance with regulations and rules therefore as required in the current manual of survey instructions of the United States Department of the Interior, Bureau of Land Management or by a decree of a Court of Law and /or that the corner points mentioned in lines 3, 4 and 5 above were in conformance with the rules of the Michigan Board of Land Surveyors or by a Decree of a Court of Law, established, re-established, monumented, recovered, found as expressed below:

	A	B	C	D	E	F	G	H	I	J	K	L	M
1													
2	6		5			4		3		2		1	
3													
4	7		8			9	●	10		11		12	
5													
6	18		17			16		15		14		13	
7													
8	19		20			21		22		23		24	
9													
10	30		29			28		27		26		25	
11													
12	31		32			33		34		35		36	
13													


NOTE: Not more than 2 corners, all in the same town and range, may be recorded on this certificate.

A. Description of original monument and accessories and/or subsequent restoration:

G-4 1/4 Corner Common to Sections 9 & 10, Town 46 North, Range 1 West
1845 - Original ties (James Mullett): Fir 4, S31°W 31 links - Spruce 10, N49°W 08 links.
Circa 1900 - County Surveyor Frederick H. Brown notes indicate "the bearing tree to this 1/4 post stood there on the edge of the right of way, just outside the railway fence I think." His drawing of Section 10 shows corner midway between section corners 2705 feet north and south. An angle in the southwest quadrant of this corner from the section line south to the east-west 1/4 of Section 9 to the west is shown as 95°34'.

B. Description of corner evidence found and/or method applied in restoring or reestablishing corner:

This corner is being re-established as part of the Chippewa County Remonumentation Program.
Found no evidence of corner. Re-established corner on line between section corners 2709.46 feet north and 2684.14 feet south, on the extension of an old fence line to the west. The measured angle in the southwest quadrant (as described above) using this position is 95°32'46". I believe that the fence is the best available evidence of the corner location as described by Brown.

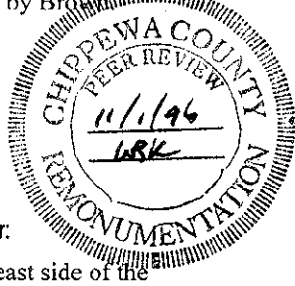

C. Description of monument for corner and accessories established to perpetuate locating the position of the corner:

Corner is a 3/4" x 24" rebar with a plastic Chippewa County Remonumentation cap in a cultivated field, on the east side of the railroad tracks, which are on the east side of the Soo Line Road. Witnesses:
Power Pole (E-30), S40°W 267.07'
Power Pole (E-29), N60°W 182.04'
3" White Birch, N42°W 86.76'
Center of Easterly Rail, WEST 106.34'

Note: Unless noted otherwise, distances are to a nail/tag #33142 in the side of the witness object. Bearings are compass bearings corrected for declination. Trees are blazed and painted.

Signed by Keith R. Waters
Surveyor's Michigan License No. 33142

Date 12-30-96

BOOK 10 PAGE 21