

**SURVEY & REMONUMENTATION**

MAY 28 1997

**CHIPPEWA COUNTY REMONUMENTATION CORNER**

**LAND CORNER RECORDATION CERTIFICATE**  
Filing Requirement of Act 74, Mich. P.A. 1970


\$7.00 RECORDING FEE

For corners in

**COMMISSION**

Chippewa Located In: Corner Code #  
(County)

- 1. Public Land Survey T46N R 1W G-5  
T R  
T R  
T R
- 2. Property Controlling in Section S T R  
S T R
- 3. Miscellaneous Property in Sec. S T R  
S T R

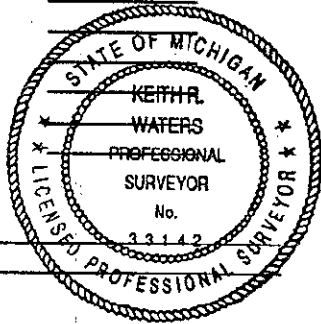

- 4. Lot No. \_\_\_\_\_, Recorded Plat \_\_\_\_\_
- 5. Private Claims \_\_\_\_\_

I, Keith R. Waters, in a field survey on 09/08, 1996 do hereby state that under requirements of P.A. 74, Michigan P.A. of 1970, the corner points mentioned in lines 1 and 2 above were in conformance with regulations and rules therefore as required in the current manual of survey instructions of the United States Department of the Interior, Bureau of Land Management or by a decree of a Court of Law and /or that the corner points mentioned in lines 3, 4 and 5 above were in conformance with the rules of the Michigan Board of Land Surveyors or by a Decree of a Court of Law; established, re-established, monumented, recovered, found as expressed below:

**NOTE: Not more than 2 corners, all in the same town and range, may be recorded on this certificate.**

\$2.00 MSSR  
3/3/1997 5:08:58 PM Receipt #275  
RECEIVED FOR RECORD  
CHIPPEWA COUNTY - STATE OF MICHIGAN  
SHARON H. KENNEDY, REGISTER OF DEEDS  
**BOOK 10 PAGE 22**  
Register of Deeds Stamp & File Number

|    | A  | B | C  | D | E  | F | G  | H | I  | J | K  | L | M |
|----|----|---|----|---|----|---|----|---|----|---|----|---|---|
| 1  |    |   |    |   |    |   |    |   |    |   |    |   |   |
| 2  | 6  |   | 5  |   | 4  |   | 3  |   | 2  |   | 1  |   |   |
| 3  |    |   |    |   |    |   |    |   |    |   |    |   |   |
| 4  | 7  |   | 8  |   | 9  |   | 10 |   | 11 |   | 12 |   |   |
| 5  |    |   |    |   |    |   | ●  |   |    |   |    |   |   |
| 6  | 18 |   | 17 |   | 16 |   | 15 |   | 14 |   | 13 |   |   |
| 7  |    |   |    |   |    |   |    |   |    |   |    |   |   |
| 8  | 19 |   | 20 |   | 21 |   | 22 |   | 23 |   | 24 |   |   |
| 9  |    |   |    |   |    |   |    |   |    |   |    |   |   |
| 10 | 30 |   | 29 |   | 28 |   | 27 |   | 26 |   | 25 |   |   |
| 11 |    |   |    |   |    |   |    |   |    |   |    |   |   |
| 12 | 31 |   | 32 |   | 33 |   | 34 |   | 35 |   | 36 |   |   |
| 13 |    |   |    |   |    |   |    |   |    |   |    |   |   |

**A. Description of original monument and accessories and/or subsequent restoration:**

G-5 Corner Common to Sections 9, 10, 15, & 16, Town 46 North, Range 1 West  
1845 - Original ties (James Mullett): White Pine 10, N19°E 23 links - Fir 6, S43°W 30 links.  
1890 - County Surveyor Frederick H. Brown notes indicate an original corner and original bearing tree. Corner is 141 feet east of the centerline of railroad tracks.  
Circa 1920's - County Surveyor notes show corner with assorted witnesses, including a distance of 140 feet west to centerline of railroad tracks.


**B. Description of corner evidence found and/or method applied in restoring or reestablishing corner:**

This corner is being perpetuated as part of the Chippewa County Remonumentation Program.  
Found an old 3 3/4" diameter concrete monument on the south edge of a 2 track road (8 Mile Road). Monument is 139.92 feet east of the centerline of north-south railroad tracks. Accepted corner as found and established witness objects.

**C. Description of monument for corner and accessories established to perpetuate locating the position of the corner:**

Corner is a 3 3/4" diameter concrete monument on the south edge of an east-west 2 track road (8 Mile Road).  
Witnesses:  
Power Pole (E-38), N85°W 194.71'  
8" Aspen, S48°W 76.77'  
4" Aspen, S40°E 22.62'  
Centerline of Railroad Tracks, WEST 139.92'

Note: Unless noted otherwise, distances are to a nail/tag #33142 in the side of the witness object. Bearings are compass bearings corrected for declination. Trees are blazed and painted.

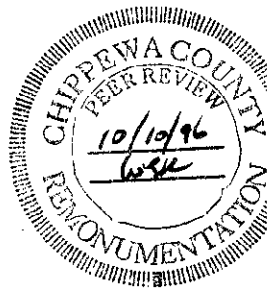

Signed by Keith R. Waters  
Surveyor's Michigan License No. 33142

Date 12-30-96

**BOOK 10 PAGE 22**