

SURVEY & REMONUMENTATION

CHIPPEWA COUNTY REMONUMENTATION CORNER

APR 27 1995

LAND CORNER RECORDATION CERTIFICATE
Filing Requirement of Act 74, Mich. P.A. 1970

For corners in **CHIPPEWA** COMMISSION
Chippewa

Located In: _____ Corner Code # _____


1. Public Land Survey T 46N R 1W G-8
T _____ R _____
T _____ R _____
T _____ R _____

2. Property Controlling in Section S _____ R _____
S _____ R _____
S _____ R _____

3. Miscellaneous Property in Sec. S _____ T _____
S _____ T _____

4. Lot No. _____ Recorded Plat _____

5. Private Claims _____

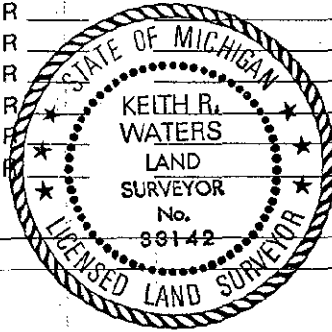

\$ 7.00 LAND CORNER
\$ 2.00 NSSR
5 DEC 94 12:30 P.M. RECEIPT# 1519
RECEIVED FOR RECORD
CHIPPEWA COUNTY - STATE OF MICHIGAN
SHARON H. KENNEDY, REGISTER OF DEEDS

Register of Deeds Stamp & File Number

	A	B	C	D	E	F	G	H	I	J	K	L	M
2	6		5		4		3		2		1		
3													
4	7		8		9		10		11		12		
5													
6	18		17		16		15		14		13		
7													
8	19		20		21		22		23		24		
9													
10	30		29		28		27		26		25		
11													
12	31		32		33		34		35		36		
13													


I, Keith R. Waters in a field survey on December 22, 19 93, do hereby certify that under requirements of P.A. 74, Michigan P.A. of 1970, the corner points mentioned in lines 1 and 2 above were in conformance with regulations and rules therefore as required in the current manual of survey instructions of the United States Department of the Interior, Bureau of Land Management or by a decree of a Court of Law and/or that the corner points mentioned in lines 3, 4 and 5 above were in conformance with the rules of the Michigan Board of Land Surveyors or by a Decree of a Court of Law; established, re-established, monumented, re-monumented, recovered, found as expressed below:

NOTE: Not more than 4 corners, all in the same town and range, may be recorded on this certificate.

A. Description of original monument and accessories and/or subsequent restoration:
G-8 1/4 Corner Common to Sections 21 & 22, T46N, R1W
Original ties to post: Spruce 20, N53°W 21 links
Black Ash 8, S32°E 15 links

Old sketches in County Surveyor's office show corner midway between Section corners 5197 feet apart.

B. Description of corner evidence found and/or method applied in restoring or reestablishing corner:
G-8 (T46N, R1W)
This corner is being re-established as part of the Chippewa County Remonumentation Program.
Found no evidence of corner or its accessories. Distance between Section corners north and south is 5198.44 feet (County Surveyor notes show distance as 5197). Re-established corner midway on line between said Section corners 2599.22 feet north and 2599.22 feet south. Corner is on the east side of the railroad tracks, which are on the east side of the Soo Line Road.
Corner is approximately 20 feet north of a fence line to the east.

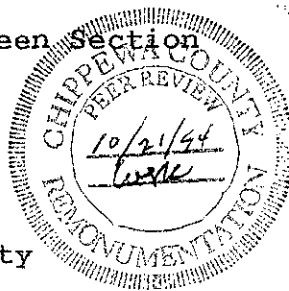

C. Description of monument for corner and accessories established to perpetuate locating the position of the corner:
G-8 (T46N, R1W)
Corner is a 3/4" x 24" rebar with 3/4" aluminum Chippewa County Remonumentation cap on the east side of railroad tracks. Witnesses:

- Power Pole (E67), S71°W 92.12'
- East edge of Easterly rail, WEST 29.24'
- 7" Aspen, S75°E 36.86'
- 5" Aspen, S31°E 27.79'

Note: Unless noted otherwise, distances are to a nail and tag in side of witness object. Bearings are compass bearings corrected for declination. Distances are measured with EDM. Trees are blazed and painted.

Signed by Keith R. Waters Date 10-25-94
Surveyor's Michigan License No. 33142