

**SURVEY &
REMONUMENTATION**

CHIPPEWA COUNTY REMONUMENTATION CORNER

APR 27 1995

LAND CORNER RECORDATION CERTIFICATE
Filing Requirement of Act 74, Mich. P.A. 1970

COMMISSION


For corners in
Chippewa

(County)

Located In:

Corner Code #:

- 1. Public Land Survey T 46N R 1W G-10
T _____ R _____
T _____ R _____
T _____ R _____
- 2. Property Controlling S _____ R _____
in Section S _____ T _____
3. Miscellaneous S _____ T _____
Property in Sec. S _____ T _____ R _____
- 4. Lot No. _____ Recorded Plat _____
- 5. Private Claims _____

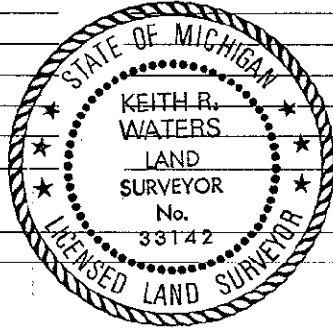

\$ 7.00 LAND CORNER
\$ 2.00 MSSR
5 DEC 94 12:31 P.M. RECEIPT# 1519
RECEIVED FOR RECORD
CHIPPEWA COUNTY - STATE OF MICHIGAN
SHARON H. KENNEDY, REGISTER OF DEEDS
Register of Deeds Stamp & File Number

	A	B	C	D	E	F	G	H	I	J	K	L	M
2	6	5	4	3	2	1							
3													
4	7	8	9	10	11	12							
5													
6	18	17	16	15	14	13							
7													
8	19	20	21	22	23	24							
9													
10	30	29	28	27	26	25							
11													
12	31	32	33	34	35	36							
13													

I, Keith R. Waters, in a field survey on April 8, 1994, do hereby certify that under requirements of P.A. 74, Michigan P.A. of 1970, the corner points mentioned in lines 1 and 2 above were in conformance with regulations and rules therefore as required in the current manual of survey instructions of the United States Department of the Interior, Bureau of Land Management or by a decree of a Court of Law and/or that the corner points mentioned in lines 3, 4 and 5 above were in conformance with the rules of the Michigan Board of Land Surveyors or by a Decree of a Court of Law; established, re-established, monumented, re-monumented, recovered, found as expressed below:


NOTE: Not more than 4 corners, all in the same town and range, may be recorded on this certificate.

A. Description of original monument and accessories and/or subsequent restoration:

G-10 1/4 Corner Common to Sections 27 & 28, T46N, R1W.
Original notes indicate White Pine 12 for 1/4 Section corner.
1908 - County Surveyor notes in Section 27 show corner at split between section corners 2616 feet north and south. Notes in Section 28 show corner at split between section corners 2617 feet north and south.

B. Description of corner evidence found and/or method applied in restoring or reestablishing corner:

G-10 (T46N, R1W)
This corner is being re-established as part of the Chippewa County Remonumentation Program.
Found no evidence of corner or its accessories. Re-established corner by single proportionate measurement on line between section corners 2615.55 feet north and 2615.55 feet south. Corner falls on the east side of north-south railroad tracks. Corner is online with the extension of an east-west fence line on the west side of the railroad tracks, and is approximately 15 feet north of an east-west fence line on the east side of the railroad tracks.

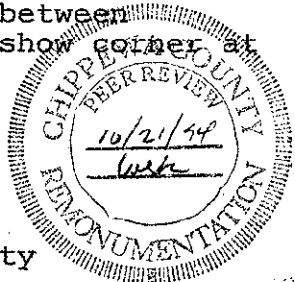

C. Description of monument for corner and accessories established to perpetuate locating the position of the corner:

G-10 (T46N, R1W)
Corner is a 3/4" x 24" rebar with 3/4" aluminum Chippewa County Remonumentation cap on the east side of north-south railroad tracks. Witnesses:
16" Spruce, S25°E 24.35'
6" Spruce, N56°E 31.72'
8" Aspen, N31°E 26.19'
E. Edge E'ly Rail, WEST 38.00'
Note: Distances are to a nail and tag in the side of the tree. Trees are blazed and painted. Bearings are compass bearings corrected for declination.

Signed by Keith R. Waters Date 10-25-94
Surveyor's Michigan License No. 33142