

SURVEY & REMONUMENTATION

MAY 28 1997

COMMISSIONER CHIPPEWA COUNTY REMONUMENTATION CORNER

**LAND CORNER RECORDATION CERTIFICATE
Filing Requirement of Act 74, Mich. P.A. 1970**

For corners in

Chippewa (County)	Located In:	Corner Code #
1. Public Land Survey	T <u>46N</u> R <u>1W</u>	<u>G-12</u>
	T <u> </u> R <u> </u>	<u> </u>
	T <u> </u> R <u> </u>	<u> </u>
	T <u> </u> R <u> </u>	<u> </u>
2. Property Controlling in Section	S <u> </u> T <u> </u> R <u> </u>	<u> </u>
	S <u> </u> T <u> </u> R <u> </u>	<u> </u>
3. Miscellaneous Property in Sec.	S <u> </u> T <u> </u> R <u> </u>	<u> </u>
	S <u> </u> T <u> </u> R <u> </u>	<u> </u>

\$7.00 RECORDING FEE

\$2.00 MSSR

3/3/1997 5:10:33 PM Receipt #275
RECEIVED FOR RECORD
CHIPPEWA COUNTY - STATE OF MICHIGAN
SHARON H. KENNEDY, REGISTER OF DEEDS

BOOK **10** PAGE **26**

Register of Deeds Stamp & File Number

4. Lot No. _____, Recorded Plat _____
5. Private Claims _____

I, Keith R. Waters, in a field survey on 03/11, 1996 do hereby state that under requirements of P.A. 74, Michigan P.A. of 1970, the corner points mentioned in lines 1 and 2 above were in conformance with regulations and rules therefore as required in the current manual of survey instructions of the United States Department of the Interior, Bureau of Land Management or by a decree of a Court of Law and /or that the corner points mentioned in lines 3, 4 and 5 above were in conformance with the rules of the Michigan Board of Land Surveyors or by a Decree of a Court of Law; established, re-established, monumented, recovered, found as expressed below:

NOTE: Not more than 2 corners, all in the same town and range, may be recorded on this certificate.

A	B	C	D	E	F	G	H	I	J	K	L	M
1												
2	6	5	4	3	2	1						
3												
4	7	8	9	10	11	12						
5												
6	18	17	16	15	14	13						
7												
8	19	20	21	22	23	24						
9												
10	30	29	28	27	26	25						
11												
12	31	32	33	34	35	36						
13												

A. Description of original monument and accessories and/or subsequent restoration:

G-12 1/4 Corner Common to Sections 33 & 34, Town 46 North, Range 1 West
1845 - Original ties (James Mullett): Birch 4, N72°W 17 links - Spruce 6, S71°E 16 links.
1881, 1891 - County Surveyor Frederick H. Brown shows corner midway between section corners. Distance between section corners is shown as 5173 feet.

B. Description of corner evidence found and/or method applied in restoring or reestablishing corner:


This corner is being re-established as part of the Chippewa County Remonumentation Program. Found no evidence of this corner. Re-established corner by single proportionate measurement between section corners north and south. The distance between section corners is 5171.42 feet, above mentioned County Surveyor notes show 5173 feet.



C. Description of monument for corner and accessories established to perpetuate locating the position of the corner:

Corner is a 3/4" x 24" rebar with a plastic Chippewa County Remonumentation cap approximately 13 feet east of the easterly right-of-way fence of I-75. Witnesses:
6" Balsam Fir, N46°E 54.45'
9" White Birch, N59°E 54.71'
7" Balsam Fir, S77°E 31.88'
7" Red Maple in Clump, S46°E 50.81'

Note: Distances are to a nail/tag #33142 in the side of the witness object. Bearings are compass bearings corrected for declination. Trees are blazed and painted.

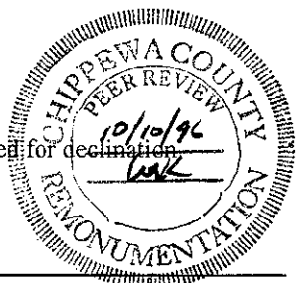

Signed by Keith R. Waters
Surveyor's Michigan License No. 33142

Date 12-30-96

BOOK **10** PAGE **26**