

**SURVEY & REMONUMENTATION**

CHIPPEWA COUNTY REMONUMENTATION CORNER

APR 27 1995

**LAND CORNER RECORDATION CERTIFICATE**  
Filing Requirement of Act 74, Mich. P.A. 1970


**COMMISSION**

For corners in Chippewa

(County)

Located In: Corner Code #

- 1. Public Land Survey T 46N R 1W H-7
- T \_\_\_\_\_ R \_\_\_\_\_
- T \_\_\_\_\_ R \_\_\_\_\_
- T \_\_\_\_\_ R \_\_\_\_\_
- 2. Property Controlling S \_\_\_\_\_ T \_\_\_\_\_ R \_\_\_\_\_
- in Section S \_\_\_\_\_ T \_\_\_\_\_ R \_\_\_\_\_
- 3. Miscellaneous S \_\_\_\_\_ T \_\_\_\_\_ R \_\_\_\_\_
- Property in Sec. S \_\_\_\_\_ T \_\_\_\_\_ R \_\_\_\_\_
- 4. Lot No. \_\_\_\_\_, Recorded Plat \_\_\_\_\_
- 5. Private Claims \_\_\_\_\_

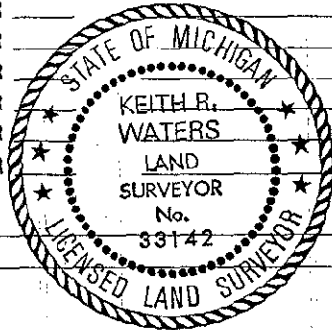

\$ 7.00 LAND CORNER  
\$ 2.00 MSSR  
5 DEC 94 12:31 P.M. RECEIPT# 1519  
RECEIVED FOR RECORD  
CHIPPEWA COUNTY - STATE OF MICHIGAN  
SHARON H. KENNEDY, REGISTER OF DEEDS

Register of Deeds Stamp & File Number

	A	B	C	D	E	F	G	H	I	J	K	L	M
2	6	5	4	3	2	1							
3													
4	7	8	9	10	11	12							
5													
6	18	17	16	15	14	13							
7													
8	19	20	21	22	23	24							
9													
10	30	29	28	27	26	25							
11													
12	31	32	33	34	35	36							
13													

I, Keith R. Waters, in a field survey on December 22, 1993, do hereby certify that under requirements of P.A. 74, Michigan P.A. of 1970, the corner points mentioned in lines 1 and 2 above were in conformance with regulations and rules therefore as required in the current manual of survey instructions of the United States Department of the Interior, Bureau of Land Management or by a decree of a Court of Law and/or that the corner points mentioned in lines 3, 4 and 5 above were in conformance with the rules of the Michigan Board of Land Surveyors or by a Decree of a Court of Law; established, re-established, monumented, re-monumented, recovered, found as expressed below:

**NOTE: Not more than 4 corners, all in the same town and range, may be recorded on this certificate.**

A. Description of original monument and accessories and/or subsequent restoration:

H-7 1/4 Corner Common to Sections 15 & 22, T46N, R1W

Original notes indicate a Fir, 10" in diameter, for corner.

Subsequent County Surveyor notes show the distance from this corner to the Section corner west as 2626 feet.

1987 - MDOT notes show distance between Section corners east and west for this corner as 5265.05 feet, no location is shown for 1/4 corner.

B. Description of corner evidence found and/or method applied in restoring or reestablishing corner:

H-7 (T46N, R1W)

This corner is being re-established as part of the Chippewa County Remonumentation Program.

Found no evidence of corner or its accessories. Re-established corner on line between Section corners 2638.61 feet east and 2626.65 feet west, on the extension of a fence line to the south. East-west position fits well with that as shown in above County Surveyor notes. Position also works well with a fence at the west 1/16 line of Section 22. Corner falls in the approximate centerline of Highway M-28.

C. Description of monument for corner and accessories established to perpetuate locating the position of the corner:

H-7 (T46N, R1W)

Corner is a 3/4" rebar with a plastic Chippewa County Remonumentation cap in the approximate centerline of Highway M-28. Witnesses:

- Nail/tag in top of guard rail post, S78°E 191.16'
- Power Pole (DR3-3), SOUTH 75.95'
- NE Corner Cloverland Building, S52°W 188.97'
- Power Pole, S71°W 240.70'

Note: Unless noted otherwise, distances are to a nail and tag in side of witness object. Bearings are compass bearings corrected for declination. Distances are measured with EDM.

Signed by Keith R. Waters

Date 10-25-94

Surveyor's Michigan License No. 33142

