

SURVEY & REMONUMENTATION

APR 27 1995

CHIPPEWA COUNTY REMONUMENTATION CORNER

LAND CORNER RECORDATION CERTIFICATE

Filing Requirement of Act 74, Mich. P.A. 1970

For corners in **COMMISSION**

<u>Chippewa</u> (County)	Located In:	Corner Code #:
1. Public Land Survey	T <u>46N</u> R <u>1W</u>	<u>H-13</u>
	T _____ R _____	_____
	T _____ R _____	_____
	T _____ R _____	_____
2. Property Controlling in Section	S _____ T _____ R _____	_____
	S _____ T _____ R _____	_____
3. Miscellaneous Property in Sec.	S _____ T _____ R _____	_____
	S _____ T _____ R _____	_____
4. Lot No. _____, Recorded Plat		
5. Private Claims _____		

\$ 7.00 LAND CORNER
 \$ 2.00 MSSR
 5 DEC 94 12:24 P.M. RECEIPT# 1518
 RECEIVED FOR RECORD
 CHIPPEWA COUNTY - STATE OF MICHIGAN
 SHARON H. KENNEDY, REGISTER OF DEEDS

Register of Deeds Stamp & File Number

I, William L. Karr, in a field survey on October 28, 1994, do hereby certify that under requirements of P.A. 74, Michigan P.A. of 1970, the corner points mentioned in lines 1 and 2 above were in conformance with regulations and rules therefore as required in the current manual of survey instructions of the United States Department of the Interior, Bureau of Land Management or by a decree of a Court of Law and/or that the corner points mentioned in lines 3, 4 and 5 above were in conformance with the rules of the Michigan Board of Land Surveyors or by a Decree of a Court of Law; established, re-established, monumented, re-monumented, recovered, found as expressed below:

NOTE: Not more than 4 corners, all in the same town and range, may be recorded on this certificate.

A. Description of original monument and accessories and/or subsequent restoration:

(H-13) South 1/4 Corner Section 34, T.46 N., R.1 W. (Not common)

1840: Austin Burt set post Tamarack 6 N53E 6
 Tamarack 4 N62W 15

- : County Surveyor notes show South line of Section 34 as measuring 5262 (5263.35' today)

B. Description of corner evidence found and/or method applied in restoring or reestablishing corner:



(H-13) This corner is being re-established as part of the Chippewa County Remonumentation program.

Found no evidence of original corner position. Distance between S.C. 34/35 and S.C. 33/34 is 5263.35'. Re-established corner position midway and on-line between these corners. Corner falls 2' East of centerline of a road to the North and 25' North of centerline extended of road to the East. Corner also falls 33' East of R.O.W. fence to the North and 38' West of R.O.W. fence to the North. North 1/4 corner of Section 3 falls East 19.80' (GLO-19.80')

C. Description of monument for corner and accessories established to perpetuate locating the position of the corner:

(E-7) Corner is a 3/4"x 24" iron with plastic "Chippewa County Remonumentation" cap 25' North of the centerline extended of 12 Mile Road.

Witnesses: P. Pole	N10°E	103.03'
P. Pole	S10°E	69.67'
15" Spruce	S71°W	61.30'
12" Tamarack	N83°W	83.45'
North 1/4 corner Section 3	East	19.80'

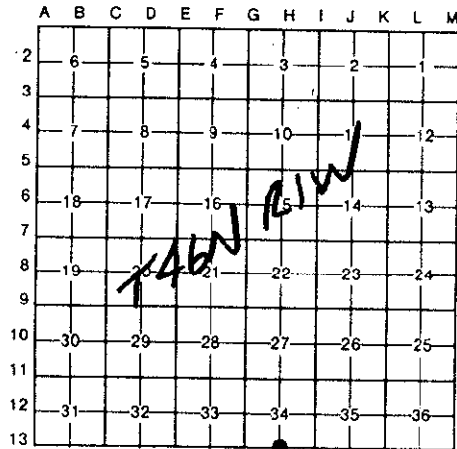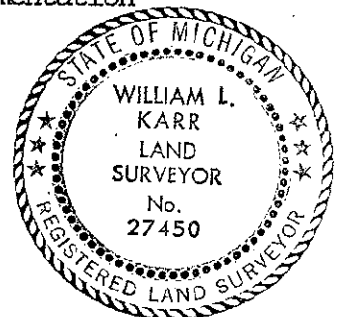

Signed by William L. Karr Date 12/2/94

Surveyor's Michigan License No. 27450

NOTE: Bearings are compass bearings corrected for declination. Distances are to a nail in side of witness objects unless noted.