

MAR 09 1992

Chippewa County Remonumentation Corner

RECEIVED FOR RECORD
CHIPPEWA COUNTY
STATE OF MICHIGAN

LAND CORNER RECORDATION CERTIFICATE
Filing Requirement of Act 74, Mich. P.A. 1970

93 DEC 29 AM 10:24

For corners in
Chippewa

(County)

Located In:

Corner Code #


1. Public Land Survey	T	<u>46N</u>	R	<u>1W</u>	<u>I-1</u>
	T		R		
	T		R		
	T		R		
2. Property Controlling in Section	S		T	R	
	S		T	R	
3. Miscellaneous Property in Sec.	S		T	R	
	S		T	R	

J. Roger Mallett
REGISTER OF DEEDS

Register of Deeds Stamp & File Number

4. Lot No. _____, Recorded Plat _____
5. Private Claims _____

I, William L. Karr, in a field survey on December 11, 19 92, do hereby certify that under requirements of P.A. 74, Michigan P.A. of 1970, the corner points mentioned in lines 1 and 2 above were in conformance with regulations and rules therefore as required in the current manual of survey instructions of the United States Department of the Interior, Bureau of Land Management or by a decree of a Court of Law and/or that the corner points mentioned in lines 3, 4 and 5 above were in conformance with the rules of the Michigan Board of Land Surveyors or by a Decree of a Court of Law; established, re-established, monumented, re-monumented, recovered, found as expressed below:

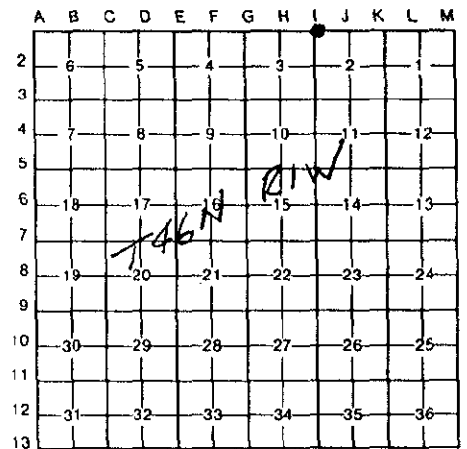

NOTE: Not more than 4 corners, all in the same town and range, may be recorded on this certificate.

A. Description of original monument and accessories and/or subsequent restoration:
(I-1) Closing Corner Common to Sections 3 and 2 (T46N-R1W)

Corner set by J.S. Mullett, D.S., August 1845. Intersected North boundary 18 links West of post 34/35.
Fir 10" S44°E 22 links
White Pine 8" S42°W 51 links


B. Description of corner evidence found and/or method applied in restoring or reestablishing corner:
(I-1) This corner is being perpetuated as part of the Chippewa County Remonumentation Program.

Found no evidence of original corner. Corner was prorated between the North 1/4 of Section 2 and closing corner common to Sections 4 and 3 in previous survey. East-West distances matched quite closely with the County Surveyor records. Corner position also matched quite well with standard corner 34/35.

C. Description of monument for corner and accessories established to perpetuate locating the position of the corner:
(I-1) Corner is a 1/2" x 24" pin with L.S. cap. Corner falls 1.5' ± South of the centerline of Six Mile Road.

Witnesses:

Power Pole (E2301)	N21°E	76.99'
Power Pole (E23)	S44°E	67.42'
Power Pole (E24)	S81°W	215.80'
Standard Corner for Sections 34/35	East	11.21'

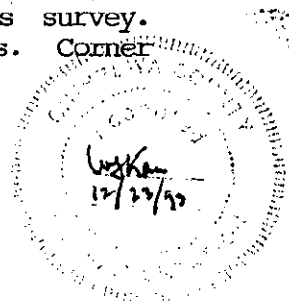

Signed by William L. Karr Date 12/23/92
27450

Surveyor's Michigan License No. _____
NOTE: Bearings are compass bearings corrected for declination.
Distances are to a nail in side of witness objects unless noted.