

MAY 28 1997

COMMISSION

CHIPPEWA COUNTY REMONUMENTATION CORNER


LAND CORNER RECORDATION CERTIFICATE

Filing Requirement of Act 74, Mich. P.A. 1970 \$7.00 RECORDING FEE

For corners in

Chippewa Located In: Corner Code #
(County)

- 1. Public Land Survey T46N R 1W I-4
T R
T R
T R
- 2. Property Controlling in Section S T R
S T R
- 3. Miscellaneous Property in Sec. S T R
S T R
- 4. Lot No. , Recorded Plat
- 5. Private Claims

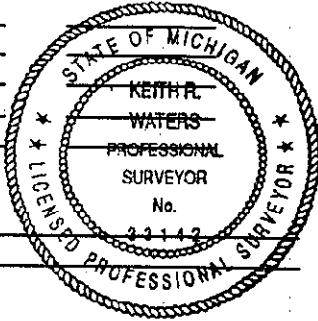

\$2.00 MSSR

3/3/1997 5:13:39 PM Receipt #275
RECEIVED FOR RECORD
CHIPPEWA COUNTY - STATE OF MICHIGAN
SHARON H. KENNEDY, REGISTER OF DEEDS

BOOK 10 PAGE 33

Register of Deeds Stamp & File Number

1	A	B	C	D	E	F	G	H	I	J	K	L	M
2	6		5		4		3		2		1		
3													
4	7		8		9		10		11		12		
5													
6	18		17		16		15		14		13		
7													
8	19		20		21		22		23		24		
9													
10	30		29		28		27		26		25		
11													
12	31		32		33		34		35		36		
13													

I, Keith R. Waters, in a field survey on 09/16, 1996 do hereby state that under requirements of P.A. 74, Michigan P.A. of 1970, the corner points mentioned in lines 1 and 2 above were in conformance with regulations and rules therefore as required in the current manual of survey instructions of the United States Department of the Interior, Bureau of Land Management or by a decree of a Court of Law and /or that the corner points mentioned in lines 3, 4 and 5 above were in conformance with the rules of the Michigan Board of Land Surveyors or by a Decree of a Court of Law, established, re-established, monumented, recovered, found as expressed below:


NOTE: Not more than 2 corners, all in the same town and range, may be recorded on this certificate.

A. Description of original monument and accessories and/or subsequent restoration:

- I-4 1/4 Corner Common to Sections 10 & 11, Town 46 North, Range 1 West
- 1845 - Original corner (James Mullett) was a 30" White Pine.
- 1898 - County Surveyor Frederick H. Brown indicates the original large pine stump, planted bricks on west side of stump.
- Circa 1920's - County Surveyor notes indicate some bricks on the west side of pine stump, which was the original corner. Put in small monument and stove casting.
- 1991 - Lawrence E. Weinreis, P.S. 32343, LCRC in liber 8, page 281, Chippewa County corner records. Found no evidence of corner. Re-established corner by single proportionate measurement. Witnesses: 12" Willow, N72°E 33.61' - Radio Antenna, S54°E - PK nail, SOUTH 17.66' - 6" Willow, N14°W 57.36'.

B. Description of corner evidence found and/or method applied in restoring or reestablishing corner:

This corner is being perpetuated as part of the Chippewa County Remonumentation Program. Found a bent 1/2" iron pin with cap #32343 and all witness objects as called for in LCRC liber 8, page 281 (willows are dead). Accepted corner location as found and replaced bent 1/2" iron with a 3/4" rebar and plastic Chippewa County Remonumentation cap.

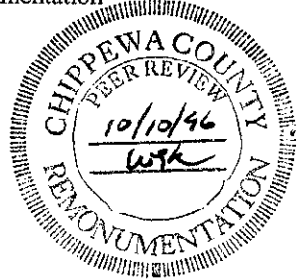

C. Description of monument for corner and accessories established to perpetuate locating the position of the corner:

Corner is a 3/4" x 24" rebar with a plastic Chippewa County Remonumentation cap in the centerline of north-south asphalt road (Elm Road). Witnesses:
6" Spruce, N87°E 133.40'
4" Scotch Pine, S47°W 105.72'
5" Aspen, N27°E 82.95'
PK Nail, SOUTH 17.66'

Note: Distances are to a nail/tag #33142 in the side of the witness object. Bearings are compass bearings corrected for declination. Trees are blazed and painted.

Signed by Keith R. Waters
Surveyor's Michigan License No. 33142

Date 12-30-96

BOOK 10 PAGE 33