

SURVEY & REMONUMENTATION

CHIPPEWA COUNTY REMONUMENTATION CORNER

APR 27 1995

LAND CORNER RECORDATION CERTIFICATE

Filing Requirement of Act 74, Mich. P.A. 1970


For corners in **COMMISSION**

For corners in	Chippewa <small>(County)</small>	Located In:	Corner Code -#
1. Public Land Survey		T <u>46N</u> R <u>1W</u>	<u>I-7</u>
		T _____ R _____	_____
		T _____ R _____	_____
		T _____ R _____	_____
2. Property Controlling in Section	S _____	T _____ R _____	_____
	S _____	T _____ R _____	_____
3. Miscellaneous Property in Sec.	S _____	T _____ R _____	_____
	S _____	T _____ R _____	_____
4. Lot No. _____, Recorded Plat _____			
5. Private Claims _____			

\$ 7.00 LAND CORNER
\$ 2.00 MSSR
 19 DEC 94 10:17 A.M. RECEIPT# 1769
 RECEIVED FOR RECORD
 CHIPPEWA COUNTY - STATE OF MICHIGAN
 SHARON H. KENNEDY, REGISTER OF DEEDS
Register of Deeds Stamp & File Number

I, William L. Karr, in a field survey on October 19, 1994, do hereby certify that under requirements of P.A. 74, Michigan P.A. of 1970, the corner points mentioned in lines 1 and 2 above were in conformance with regulations and rules therefore as required in the current manual of survey instructions of the United States Department of the Interior, Bureau of Land Management or by a decree of a Court of Law and/or that the corner points mentioned in lines 3, 4 and 5 above were in conformance with the rules of the Michigan Board of Land Surveyors or by a Decree of a Court of Law; established, re-established, monumented, re-monumented, recovered, found as expressed below:

NOTE: Not more than 4 corners, all in the same town and range, may be recorded on this certificate.

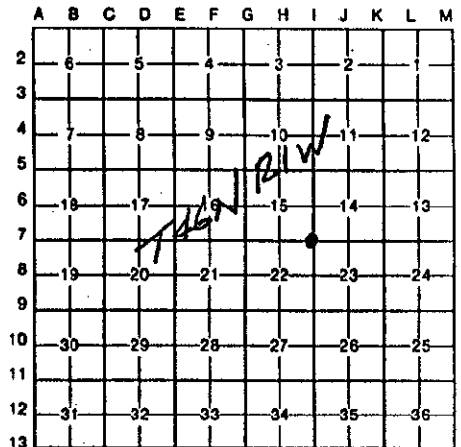

A. Description of original monument and accessories and/or subsequent restoration:

(I-7) Section Corner 14, 15, 22 & 23, T.46 N., R.1 W.

1845: J. Mullett set post cor to secs 14, 15, 22 & 23. Spruce 20 N64E 21lks

1960: MDOT found 1-1/4" axle shaft (L.02, P.227) Aspen 18 S27W 39 lks

1982: J. Fletcher found a 1/2" iron 105.5 East of the centerline of Mackinac Trail and recorded in L.06, P.017.

1985: L.R. Rogers (L.S.29251) found 1-1/4" axle shaft approximately 4' below grade and approximately 14.5' East of the 1/2" iron recorded in L.06, P.017.

1988: N.E. Hill Found 2 witnesses from the 1982 recording by Fletcher. Also found a 1/2" pin w/cap No.29251 in a monument box which had been placed over the axle shaft. Accepted the corner in the monument box & recorded in L.07, P.079)

B. Description of corner evidence found and/or method applied in restoring or reestablishing corner:


(I-7) This corner is being perpetuated as part of the Chippewa County Remonumentation program.

Found no evidence of original corner. Found a 1/2" iron w/cap No. 29251 in a monument box, 1.8' South of the centerline of M-28. Based on past documentation, accepted corner position as found.

C. Description of monument for corner and accessories established to perpetuate locating the position of the corner:

(I-7) Corner is a 1/2" iron w/cap No. 29251, 1.8' South of the centerline of M-28 and 119.95' East of the centerline of old Mackinac Trail (H-63).

Witnesses: 5" Pine	N40°E	65.04'
P. Pole (DR1/1/U)	S62°E	121.06'
P. Pole (DR3/11-1)	S25°W	57.72'
Guy Pole (RA3/45)	N25°W	52.91'

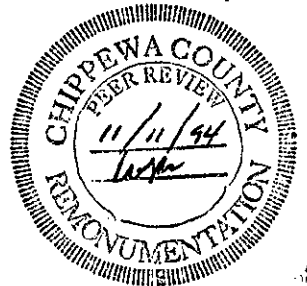

Signed by William L. Karr Date 12/2/94

Surveyor's Michigan License No. 27450

723-12

NOTE: Bearings are compass bearings corrected for declination. Distances are to a nail in side of witness objects unless noted.