

**SURVEY &
REMONUMENTATION** CHIPPEWA COUNTY REMONUMENTATION CORNER


APR 27 1995

LAND CORNER RECORDATION CERTIFICATE
Filing Requirement of Act 74, Mich. P.A. 1970

For corners in
Chippewa **COMMISSION**
(County)

Located In: _____ Corner Code # _____

- | | | |
|---------------------------------------|--------------------------|--------------|
| 1. Public Land Survey | T <u>46N</u> R <u>1W</u> | I- <u>10</u> |
| | T _____ R _____ | _____ |
| | T _____ R _____ | _____ |
| | T _____ R _____ | _____ |
| 2. Property Controlling in Section | S _____ T _____ R _____ | _____ |
| | S _____ T _____ R _____ | _____ |
| 3. Miscellaneous Property in Sec. | S _____ T _____ R _____ | _____ |
| | S _____ T _____ R _____ | _____ |
| 4. Lot No. _____, Recorded Plat _____ | | |
| 5. Private Claims _____ | | |

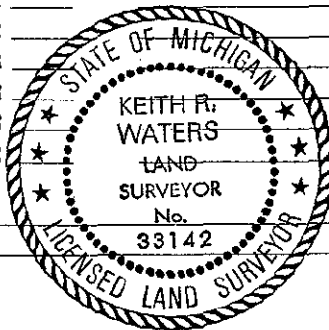


\$ 7.00 LAND CORNER
\$ 2.00 MSSR
5 DEC 94 12:31 P.M. RECEIPT# 1519
RECEIVED FOR RECORD
CHIPPEWA COUNTY - STATE OF MICHIGAN
SHARON H. KENNEDY, REGISTER OF DEEDS
Register of Deeds Stamp & File Number

	A	B	C	D	E	F	G	H	I	J	K	L	M
2	6	5	4	3	2	1							
3													
4	7	8	9	10	11	12							
5													
6	18	17	16	15	14	13							
7													
8	19	20	21	22	23	24							
9													
10	30	29	28	27	26	25							
11													
12	31	32	33	34	35	36							
13													

I, Keith R. Waters, in a field survey on April 8, 1994, do hereby certify that under requirements of P.A. 74, Michigan P.A. of 1970, the corner points mentioned in lines 1 and 2 above were in conformance with regulations and rules therefore as required in the current manual of survey instructions of the United States Department of the Interior, Bureau of Land Management or by a decree of a Court of Law and/or that the corner points mentioned in lines 3, 4 and 5 above were in conformance with the rules of the Michigan Board of Land Surveyors or by a Decree of a Court of Law; established, re-established, monumented, re-monumented, recovered, found as expressed below:

NOTE: Not more than 4 corners, all in the same town and range, may be recorded on this certificate.

A. Description of original monument and accessories and/or subsequent restoration:
I-10 1/4 Corner Common to Sections 26 & 27, T46N, R1W.
Original notes indicate Fir 6 for 1/4 Section corner.
1898 - County Surveyor notes show distances from this corner to Section corners north and south as 2627 feet and 2626 feet respectively.

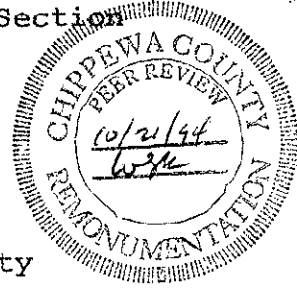

B. Description of corner evidence found and/or method applied in restoring or reestablishing corner:
I-10 (T46N, R1W)
This corner is being re-established as part of the Chippewa County Remonumentation Program.
Found no evidence of corner or its accessories. Re-established corner at the intersection of old fence lines north, south, and west. Distance to section corner north is 2625.38 feet, distance to section corner south is 2600.09 feet. Corner falls 5.6 feet east of a straight line between said section corners. Distance to section corner north is within 1.62 feet of that as shown in 1898 County Surveyor notes as shown above.

C. Description of monument for corner and accessories established to perpetuate locating the position of the corner:
I-10 (T46N, R1W)
Corner is a 3/4" x 24" rebar with 3 1/2" aluminum Chippewa County Remonumentation cap at the intersection of old fence lines north, south, and west. Witnesses:
5" Balsam Fir, WEST 3.75'
5" Balsam Fir, SOUTH 19.46'
6" Sugar Maple, S45°W 17.83'
8" Red Maple, N35°W 34.72'
Note: Distances are to a nail and tag in the side of the tree. Trees are blazed and painted. Bearings are compass bearings corrected for declination.

Signed by Keith R. Waters Date 10-25-94
Surveyor's Michigan License No. 33142