

**SURVEY & REMONUMENTATION**

APR 27 1995

CHIPPEWA COUNTY REMONUMENTATION CORNER

COMMISSION

LAND CORNER RECORDATION CERTIFICATE

Filing Requirement of Act 74, Mich. P.A. 1970

For corners in:

<u>Chippewa</u> (County)	Located In:	Corner Code #
1. Public Land Survey	T <u>46N</u> R <u>1W</u>	<u>I-13</u>
	T _____ R _____	_____
	T _____ R _____	_____
	T _____ R _____	_____
2. Property Controlling in Section	S _____ T _____ R _____	_____
	S _____ T _____ R _____	_____
3. Miscellaneous Property in Sec.	S _____ T _____ R _____	_____
	S _____ T _____ R _____	_____
4. Lot No. _____, Recorded Plat _____		
5. Private Claims _____		

\$ 7.00 LAND CORNER  
 \$ 2.00 MSSR  
 5 DEC 94 12:25 P.M. RECEIPT# 1518  
 RECEIVED FOR RECORD  
 CHIPPEWA COUNTY - STATE OF MICHIGAN  
 SHARON H. KENNEDY, REGISTER OF DEEDS

Register of Deeds Stamp & File Number

	A	B	C	D	E	F	G	H	I	J	K	L	M
2	6	5	4	3	2	1							
3													
4	7	8	9	10	11	12							
5													
6	18	17	16	15	14	13							
7													
8	19	20	21	22	23	24							
9													
10	30	29	28	27	26	25							
11													
12	31	32	33	34	35	36							
13													

I, William L. Karr, in a field survey on October 28, 19 94, do hereby certify that under requirements of P.A. 74, Michigan P.A. of 1970, the corner points mentioned in lines 1 and 2 above were in conformance with regulations and rules therefore as required in the current manual of survey instructions of the United States Department of the Interior, Bureau of Land Management or by a decree of a Court of Law and/or that the corner points mentioned in lines 3, 4 and 5 above were in conformance with the rules of the Michigan Board of Land Surveyors or by a Decree of a Court of Law; established, re-established, monumented, re-monumented, recovered, found as expressed below:

NOTE: Not more than 4 corners, all in the same town and range, may be recorded on this certificate.


A. Description of original monument and accessories and/or subsequent restoration:

(I-13) Standard Corner Sections 34/35, T.46 N., R.1 W. (Not Common)

1840: Austin Burt set post B. Ash 10 N10E 5 Cedar 14 N45W 3

1891: County Surveyor notes show S. line of Section 34 as measuring 5262' (5263.35' today).

1904: County Surveyor notes show S. line of Section 35 as measuring 5280' (5281.81' today).

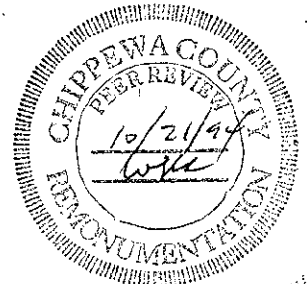

B. Description of corner evidence found and/or method applied in restoring or reestablishing corner:

(I-13) This corner is being re-established as part of the Chippewa County Remonumentation program.

Found no evidence of original corner. Found a 1/2" iron in concrete on the extension of a fenceline to the South for Closing Corner 3/2. Re-established corner position 23.10' (GLO-23.10') West of C.C. on the Township line. Corner falls 5281.51' West of Standard Corner 35/36.

C. Description of monument for corner and accessories established to perpetuate locating the position of the corner:

(I-13) Corner is a 3/4"x 24" iron with plastic "Chippewa County Remonumentation" cap and falls 6' North of the centerline of 12 Mile Road.

Witnesses: 1"x 48" pipe w/cap No.27450	North 49.95'
1"x 48" pipe w/metal cap	North 33.07'
1"x 48" pipe w/metal cap	S33°E 41.40'
1"x 48" pipe w/metal cap	S20°E 55.96'
C.C. 3/2	East 23.10'



Signed by William L. Karr Date 12/2/94

Surveyor's Michigan License No. 27450

723-12

FORM APPROVED BY MICHIGAN STATE BOARD OF LAND SURVEYORS, JAN. 28, 1971  
 REVISED MAY 14, 1975  
 REVISED JAN., 1983

NOTE: Bearings are compass bearings corrected for declination.  
 Distances are to a nail in side of witness objects unless noted.