

MAR 09 1994

Chippewa County Remonumentation Corner

LAND CORNER RECORDATION CERTIFICATE  
Filing Requirement of Act 74, Mich. P.A. 1970

93 DEC 29 AM 10: 24

*J. Roger Malott*  
REGISTER OF DEEDS

For corners in

Chippewa

(County)


Located In:

Corner Code #:

- 1. Public Land Survey T 46N R 1W J-1
- 2. Property Controlling in Section S \_\_\_ T \_\_\_ R \_\_\_
- 3. Miscellaneous Property in Sec. S \_\_\_ T \_\_\_ R \_\_\_
- 4. Lot No. \_\_\_\_\_, Recorded Plat \_\_\_\_\_
- 5. Private Claims \_\_\_\_\_

Register of Deeds Stamp & File Number

I, William L. Karr, in a field survey on September 12, 19 93, do hereby certify that under requirements of P.A. 74, Michigan P.A. of 1970, the corner points mentioned in lines 1 and 2 above were in conformance with regulations and rules therefore as required in the current manual of survey instructions of the United States Department of the Interior, Bureau of Land Management or by a decree of a Court of Law and/or that the corner points mentioned in lines 3, 4 and 5 above were in conformance with the rules of the Michigan Board of Land Surveyors or by a Decree of a Court of Law; established, re-established, monumented, re-monumented, recovered, found as expressed below:

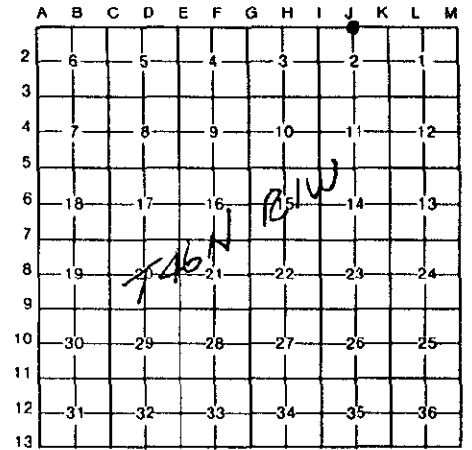

NOTE: Not more than 4 corners, all in the same town and range, may be recorded on this certificate.

A. Description of original monument and accessories and/or subsequent restoration:

(J-1) North 1/4 Corner of Section 2 (T46N-R1W)

Corner not set in original survey.

1960: J.P. Smallwood, Michigan Highway Department, recorded in Liber 3, Page 236 of the Chippewa County Corner Records.  
Found a 3/4" iron. Recorded as Common.

B. Description of corner evidence found and/or method applied in restoring or reestablishing corner:

(J-1) This corner is being perpetuated as part of the Chippewa County Remonumentation Program.

Found a 3/4" Iron in a monument box 1.8' East of the West edge of concrete in South-bound lane of I-75. Corner was determined to be the North 1/4 corner of Section 2 and NOT the South 1/4 corner of Section 35. Highway construction plans show a fence extending South from this corner. East-West distances to the Northeast and Northwest corners of Section 2 match closely with old County Surveyor distances. Also found a drill hole in the concrete overpass directly above the corner position.

C. Description of monument for corner and accessories established to perpetuate locating the position of the corner:

(J-1) Corner is a 3/4" iron in a monument box 1.8' East of the West edge of concrete in the South-bound lane of I-75, directly under a drill hole in the concrete overpass.

Witnesses:

- 9" Poplar N04°E 60.88'
- 20" Spruce N22°E 78.22'
- 4" Triple Maple S46°E 62.92'
- Power Pole (E 124) S63°W 119.19'
- South 1/4 Corner Section 35 East 10.92'



Signed by *William L. Karr*

Date 12/23/93