

MAY 28 1997 CHIPPEWA COUNTY REMONUMENTATION CORNER

COMMISSION

LAND CORNER RECORDATION CERTIFICATE

Filing Requirement of Act 74, Mich. P.A. 1970

\$7.00 RECORDING FEE

For corners in

Chippewa

(County)

Located in:

Corner Code #

1. Public Land Survey

T46N R 1W J-9

T R

T R

T R

2. Property Controlling in Section


S T R

S T R

3. Miscellaneous Property in Sec.

S T R

S T R

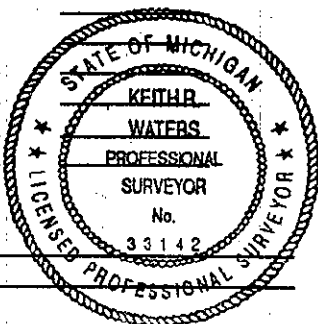

\$2.00 NSSR

3/3/1997 5:16:36 PM Receipt #275
RECEIVED FOR RECORD
CHIPPEWA COUNTY - STATE OF MICHIGAN
SHARON H. KENNEDY, REGISTER OF DEEDS

BOOK 10 PAGE 41

Register of Deeds Stamp & File Number

4. Lot No. _____, Recorded Plat _____

5. Private Claims _____

	A	B	C	D	E	F	G	H	I	J	K	L	M
1													
2	6	5	4	3	2	1							
3													
4	7	8	9	10	11	12							
5													
6	18	17	16	15	14	13							
7													
8	19	20	21	22	23	24							
9													
10	30	29	28	27	26	25							
11													
12	31	32	33	34	35	36							
13													

Keith R. Waters

11/12 96

I, _____, in a field survey on _____, 19____ do hereby state that under requirements of P.A. 74, Michigan P.A. of 1970, the corner points mentioned in lines 1 and 2 above were in conformance with regulations and rules therefore as required in the current manual of survey instructions of the United States Department of the Interior, Bureau of Land Management or by a decree of a Court of Law and /or that the corner points mentioned in lines 3, 4 and 5 above were in conformance with the rules of the Michigan Board of Land Surveyors or by a Decree of a Court of Law; established, re-established, monumented, recovered, found as expressed below:

NOTE: Not more than 2 corners, all in the same town and range, may be recorded on this certificate.

A. Description of original monument and accessories and/or subsequent restoration:

J-9 1/4 Corner Common to Sections 23 & 26, Town 46 North, Range 1 West

1845 - Original ties (James Mullett): Hemlock 12, S51°W 23 links - Fir 8, N66°E 12 links.

1889, 1892 - Drawings of Sections 23 & 26 by County Surveyor Frederick H. Brown show corner midway between section corners 2621.5 feet east and west.


1959 - Ray Walker, Highway Department, liber 3, page 226, Chippewa County corner records. 1/4 section corner is a 1 1/2" iron pipe in pavement. Witnesses: Fence post, S02°W 32.87' - Fence post, N04°E 35.83'.

B. Description of corner evidence found and/or method applied in restoring or reestablishing corner:

This corner is being perpetuated as part of the Chippewa County Remonumentation Program.

Found a pinched top 1 1/2" iron pipe and a Highway Department tag in a fence post to the north as called for in 1959 Highway Department records. Pipe is 2623.56 feet from section corner to the east, 2618.97 feet from section corner to the west, and is 1.5 feet south of a straight line between said section corners. Corner is on the extension of an old fence line to the north.

Accepted corner as found and established new witness objects.

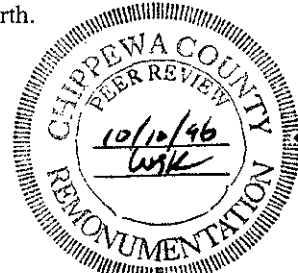

C. Description of monument for corner and accessories established to perpetuate locating the position of the corner:

Corner is a 1 1/2" iron pipe with a pinched top in the approximate centerline of 10 Mile Road (gravel), on the extension of a fence line to the north. Witnesses:

Highway Department nail and tag in fence post, N03°E 35.76'

7" Spruce, S77°E 203.32'

Power Pole, N59°W 86.06'

Power Pole (DR2-74-40), N85°E 335.25'

Note: Unless noted otherwise, distances are to a nail/tag #33142 in the side of the witness object. Bearings are compass bearings corrected for declination. Spruce is blazed and painted.

Signed by Keith R. Waters

Date 12-30-96

Surveyor's Michigan License No. 33142

BOOK 10 PAGE 41