

SURVEY & REMONUMENTATION

APR 27 1995

CHIPPEWA COUNTY REMONUMENTATION CORNER

COMMISSION

LAND CORNER RECORDATION CERTIFICATE

Filing Requirement of Act 74, Mich. P.A. 1970

For corners in

<u>Chippewa</u> (County)	Located In:	Corner Code #:
1. Public Land Survey	T <u>46N</u> R <u>1W</u>	<u>J-13</u>
	T _____ R _____	_____
	T _____ R _____	_____
	T _____ R _____	_____
2. Property Controlling in Section	S _____ T _____ R _____	_____
	S _____ T _____ R _____	_____
3. Miscellaneous Property in Sec.	S _____ T _____ R _____	_____
	S _____ T _____ R _____	_____
4. Lot No. _____, Recorded Plat _____		
5. Private Claims _____		

\$ 7.00 LAND CORNER
 \$ 2.00 HSSR
 5 DEC 94 12:25 P.M. RECEIPT# 1518
 RECEIVED FOR RECORD
 CHIPPEWA COUNTY - STATE OF MICHIGAN
 Register of Deeds/State of Michigan

A	B	C	D	E	F	G	H	I	J	K	L	M
2	6	5	4	3	2	1						
3												
4	7	8	9	10	11	12						
5												
6	18	17	16	15	14	13						
7												
8	19	20	21	22	23	24						
9												
10	30	29	28	27	26	25						
11												
12	31	32	33	34	35	36						
13												

T46N R1W

I, William L. Karr, in a field survey on October 28, 19 94, do hereby certify that under requirements of P.A. 74, Michigan P.A. of 1970, the corner points mentioned in lines 1 and 2 above were in conformance with regulations and rules therefore as required in the current manual of survey instructions of the United States Department of the Interior, Bureau of Land Management or by a decree of a Court of Law and/or that the corner points mentioned in lines 3, 4 and 5 above were in conformance with the rules of the Michigan Board of Land Surveyors or by a Decree of a Court of Law; established, re-established, monumented, re-monumented, recovered, found as expressed below:

NOTE: Not more than 4 corners, all in the same town and range, may be recorded on this certificate.


A. Description of original monument and accessories and/or subsequent restoration:

(J-13) South 1/4 Corner Section 35, T.46 N., R.1 W. (Not common)

1840: Austin Burt set post Spruce 18 N72E 10 Birch 6 N31W 33

1904: County Surveyor notes show South line of Section 35 as measuring 5280' (5281.51' today).

1988: L.R. Rogers set a 1/2"x 24" iron w/cap No. 29251 midway and on line between S.C. 34/35 and S.C. 35/36 for the South 1/4 corner.

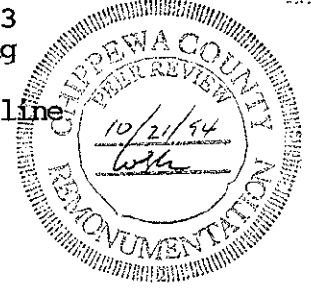

B. Description of corner evidence found and/or method applied in restoring or reestablishing corner:


(J-13) This corner is being perpetuated as part of the Chippewa County Remonumentation program.

Found no evidence of original corner. Found the 1/2" iron w/cap No. 29251 as noted in part "A". Corner falls 16.27' West of the North 1/4 Corner of Section 2. Corner falls 11.3' North of the Centerline of 12 Mile Road. Accepted corner position as found.

C. Description of monument for corner and accessories established to perpetuate locating the position of the corner:

(J-13) Corner is a 1/2" pin w/cap No. 29251, 11.3' North of the centerline of 12 Mile Road.

Witnesses: 16" Spruce	N39°E	34.27'
Fence Post	S42°E	50.87'
Fence Post	S11°W	37.59'
P. Pole(DR4/39C/19N)	N23°W	39.73'
North 1/4 Corner Section 2 East		16.27'

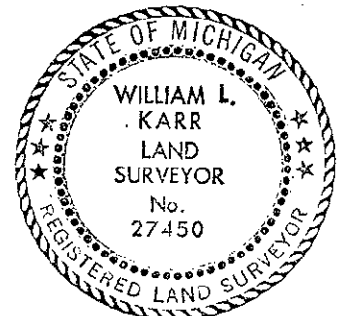

Signed by William L. Karr Date 12/2/94

Surveyor's Michigan License No. 27450

NOTE: Bearings are compass bearings corrected for declination. Distances are to a nail in side of witness objects unless noted.