SURVEY & REMONUMENTATION

APR 27 1995

COMMISSION

CHIPPEWA COUNTY REMONUMENTATION CORNER

LAND CORNER RECORDATION CERTIFICATE

Filing Requirement of Act 74, Mich. P.A. 1970

For corners in Chippewa (County)

	Located In:	Corner Code ##
1. Public Land Survey	T46N R1W	K-2
	T ___ R ___	
	T ___ R ___	
	T ___ R ___	
2. Property Controlling	S ___ T ___ R ___	
in Section	S ___ T ___ R ___	
3. Miscellaneous	S ___ T ___ R ___	
Property in Sec.	S ___ T ___ R ___	

$ 7.00 LAND CORNER
$ 2.00 MSSR
5 DEC 94 12:30 P.M. RECEIPT# 1519
RECEIVED FOR RECORD
CHIPPEWA COUNTY - STATE OF MICHIGAN
SHARON H. KENNEDY, REGISTER OF DEEDS
Register of Deeds Stamp & File Number

STATE OF MICHIGAN — KEITH R. WATERS — LAND SURVEYOR No. 33142 — LICENSED LAND SURVEYOR

4. Lot No. _____, Recorded Plat _____
5. Private Claims _____

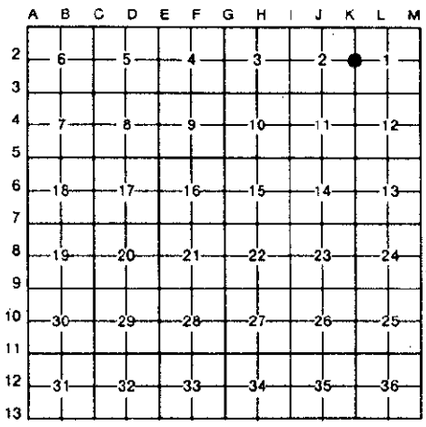

I, Keith R. Waters, in a field survey on August 17, 1994, do hereby certify that under requirements of P.A. 74, Michigan P.A. of 1970, the corner points mentioned in lines 1 and 2 above were in conformance with regulations and rules therefore as required in the current manual of survey instructions of the United States Department of the Interior, Bureau of Land Management or by a decree of a Court of Law and/or that the corner points mentioned in lines 3, 4 and 5 above were in conformance with the rules of the Michigan Board of Land Surveyors or by a Decree of a Court of Law; established, re-established, monumented, re-monumented, recovered, found as expressed below:

NOTE: Not more than 4 corners, all in the same town and range, may be recorded on this certificate.

A. Description of original monument and accessories and/or subsequent restoration:

K-2 1/4 Corner Common to Sections 1 & 2, T46N, R1W.

Original ties to post: Spruce 4, S65°W 20 links
Spruce 3, N40°E 25 links

1903 - County Surveyor notes show line between Sections 1 & 2 as being 5330.5 feet, south ½ mile as 2657 feet, and north ½ mile as 2673.50 feet. (Original G.L.O. distance between Sections 1 & 2 was 5296.50 feet)

CHIPPEWA COUNTY PEER REVIEW 10/21/94 REMONUMENTATION

B. Description of corner evidence found and/or method applied in restoring or reestablishing corner:

K-2 (T46N, R1W)
This corner is being re-established as part of the Chippewa County Remonumentation Program.
Found no evidence of corner or its accessories. Re-established corner by single proportionate measurement according to original G.L.O. notes between Section corners 2657.56 feet south and 2674.18 feet north. Distances work well with County Surveyor notes as shown above. East-west position works well with a north-south fence line on the north ½ mile between Sections 1 & 2. North-south position also works well with a very large fence post at the north 1/16 corner between Sections 1 & 2. Corner falls approximately 28 feet south of a fence corner (fences north & west).

C. Description of monument for corner and accessories established to perpetuate locating the position of the corner:

K-2 (T46N, R1W)
Corner is a 3/4" x 24" rebar with a plastic Chippewa County Remonumentation cap approximately 28 feet south of a fence corner (Fences north & west).
Witnesses:
Corner Fence Post, N10°E 28.67'
Fence Post, N31°W 33.12'
Fence Post, N51°W 49.64'
Fence Post, N65°W 70.18'

Note: Distances are to a nail and tag in the side of witness object. Bearings are compass bearings corrected for declination.

Signed by Keith R. Waters Date 10-25-94

Surveyor's Michigan License No. 33142

FORM APPROVED BY MICHIGAN STATE BOARD OF LAND SURVEYORS, JAN. 28, 1971
REVISED MAY 14, 1975
REVISED JAN., 1983