

MAY 28 1997

COMMISSION

CHIPPEWA COUNTY REMONUMENTATION CORNER

LAND CORNER RECORDATION CERTIFICATE
Filing Requirement of Act 74, Mich. P.A. 1970

For corners in

Chippewa

(County)

Located In:

Corner Code #

1. Public Land Survey

T46N R 1W

K-3

T R

T R

T R

T R

2. Property Controlling in Section

S

T R

S

T R

3. Miscellaneous Property in Sec.

S

T R

S

T R

4. Lot No. _____, Recorded Plat _____

5. Private Claims _____



\$7.00 RECORDING FEE

\$2.00 MSSR

3/3/1997 5:17:15 PM Receipt #275

RECEIVED FOR RECORD

CHIPPEWA COUNTY - STATE OF MICHIGAN
SHARON H. KENNEDY, REGISTER OF DEEDS

BOOK 10 PAGE 43

Register of Deeds Stamp & File Number

I, Keith R. Waters, in a field survey on 08/20, 1996 do hereby state that under requirements of P.A. 74, Michigan P.A. of 1970, the corner points mentioned in lines 1 and 2 above were in conformance with regulations and rules therefore as required in the current manual of survey instructions of the United States Department of the Interior, Bureau of Land Management or by a decree of a Court of Law and /or that the corner points mentioned in lines 3, 4 and 5 above were in conformance with the rules of the Michigan Board of Land Surveyors or by a Decree of a Court of Law; established, re-established, monumented, recovered, found as expressed below:

NOTE: Not more than 2 corners, all in the same town and range, may be recorded on this certificate.


	A	B	C	D	E	F	G	H	I	J	K	L	M
1													
2	6		5		4		3		2		1		
3													
4	7		8		9		10		11		12		
5													
6	18		17		16		15		14		13		
7													
8	19		20		21		22		23		24		
9													
10	30		29		28		27		26		25		
11													
12	31		32		33		34		35		36		
13													

A. Description of original monument and accessories and/or subsequent restoration:

K-3 Corner Common to Sections 1, 2, 11, & 12, Town 46 North, Range 1 West
 1845 - Original ties (James Mullett): Fir 8, N88°E 25 links - Fir 6, S65°W 40 links.
 1898 - County Surveyor Frederick H. Brown indicates that he set a post from stump of original bearing tree.
 Circa 1920's - County Surveyor notes indicate found cedar post. Set large cement post and bolt on end of cedar fence post.
 1960 - John Smallwood, Highway Department, liber 3, page 236, Chippewa County corner records. Found boat spike in cedar post.
 Witnesses: Fence post, South 33.64' - Fence post, S30°W 30.74' - Fence post, N10°E 35.12'.
 1977 - Thomas Kelly, R.L.S. 24599, liber 1, page 265, Chippewa County corner records. Found boat spike in cedar post and fence post with Highway Department tag. Witnesses: Power pole, S63°W 109.95' - 4" Spruce, S09°W 29.72' - Fence post, S55°E 93.54'.

B. Description of corner evidence found and/or method applied in restoring or reestablishing corner:

This corner is being perpetuated as part of the Chippewa County Remonumentation Program.
 Found a boat spike in a cedar post 7" below gravel road surface, 3 feet south of centerline. Distances to other recovered corners in the area check very well with those as shown in section drawings by County Surveyor Frederick H. Brown from the late 1800's.
 Accepted corner as found and established an additional witness object.

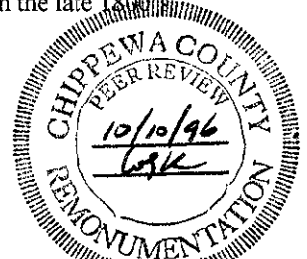

C. Description of monument for corner and accessories established to perpetuate locating the position of the corner:

Corner is a boat spike in a cedar post 7" below surface of east-west gravel road (7 Mile Road), 3 feet south of centerline). A fence line running to the south is approximately 144 feet to the west. Witnesses:
 Power Pole, S68°W 109.49'
 11" Spruce, S14°W 29.57' (side blaze only)
 Power Pole, S55°E 93.54'
 4" Spruce, N60°W 94.85' (blazed and painted)

Note: Bearings are compass bearings corrected for declination. Distances are to a nail/tag #33142 in the side of witness object.

Signed by Keith R. Waters
 Surveyor's Michigan License No. 33142

Date 12-30-96

BOOK 10 PAGE 43