

MAY 28 1997

COMMISSIONER CHIPPEWA COUNTY REMONUMENTATION CORNER

LAND CORNER RECORDATION CERTIFICATE
Filing Requirement of Act 74, Mich. P.A. 1970

For corners in
Chippewa
(County)

Located In: Corner Code #

1. Public Land Survey	T 46N	R 1W	K-4
	T	R	
	T	R	
	T	R	
2. Property Controlling in Section	S	T	R
	S	T	R
3. Miscellaneous Property in Sec.	S	T	R
	S	T	R

\$7.00 RECORDING FEE
\$2.00 MSSR
3/3/1997 5:17:33 PM Receipt #275
RECEIVED FOR RECORD
CHIPPEWA COUNTY - STATE OF MICHIGAN
SHARON H. KENNEDY, REGISTER OF DEEDS
BOOK 10 PAGE 44
Register of Deeds Stamp & File Number

4. Lot No. _____, Recorded Plat _____
5. Private Claims _____

Keith R. Waters 12/16 96
I, _____, in a field survey on _____, 19____ do hereby state that under requirements of P.A. 74, Michigan P.A. of 1970, the corner points mentioned in lines 1 and 2 above were in conformance with regulations and rules therefore as required in the current manual of survey instructions of the United States Department of the Interior, Bureau of Land Management or by a decree of a Court of Law and /or that the corner points mentioned in lines 3, 4 and 5 above were in conformance with the rules of the Michigan Board of Land Surveyors or by a Decree of a Court of Law; established, re-established, monumented, recovered, found as expressed below:

A	B	C	D	E	F	G	H	I	J	K	L	M
1												
2	6		5		4		3		2		1	
3												
4	7		8		9		10		11	●	12	
5												
6	18		17		16		15		14		13	
7												
8	19		20		21		22		23		24	
9												
10	30		29		28		27		26		25	
11												
12	31		32		33		34		35		36	
13												


NOTE: Not more than 2 corners, all in the same town and range, may be recorded on this certificate.

A. Description of original monument and accessories and/or subsequent restoration:
K-4 1/4 Corner Common to Sections 11 & 12, Town 46 North, Range 1 West

1845 - Original corner (James Mullett) was a 10" spruce.
1898 - County Surveyor Frederick H. Brown indicates that he found a fence 2687 feet north of section corner K-5.
1985 - William L. Karr, Certificate of Survey recorded in liber 428, page 102. Set 1/2" iron with cap #27450 in old corner fence post.
1991 - Lawrence E. Weinreis, P.S. 32343, LCRC liber 8, page 282. Found a 1/2" iron with cap #27450 in old rotted off corner fence post. Falls on the approximate extension of fence to the north and remains of fallen fence to the west.
Witnesses: Corner fence post, N10°E 7.31' - Fence post, N46°E 1.88' - Fence post, N56°W 15.17'

B. Description of corner evidence found and/or method applied in restoring or reestablishing corner:

This corner is being perpetuated as part of the Chippewa County Remonumentation Program. Found a 1/2" iron pin with cap #27450 and three witness objects as called for in LCRC liber 8, page 282. The distance to section corner K-5 to the south is close to that as shown in above mentioned Frederick H. Brown notes. Accepted corner as found and added additional witness object.

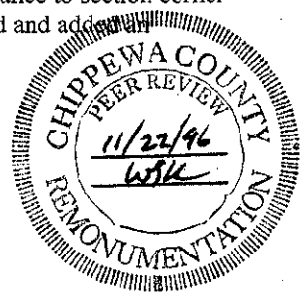

C. Description of monument for corner and accessories established to perpetuate locating the position of the corner:

Corner is a 1/2" iron pin with plastic cap #27450 in rotted corner fence post, 1.5 feet west of newer north-south fence and 7.7 feet south of newer east-west fence. Witnesses:
Corner fence post, N10°E 7.31' (Nail and tag #32343)
Fence post, N46°E 1.88' (Nail and tag #32343)
Fence post, N56°W 15.17' (Nail and tag #32343)
4" Spruce, S20°W 66.59' (Nail and tag #33142)



Note: Bearings are compass bearings corrected for declination.

Signed by Keith R. Waters
Surveyor's Michigan License No. 33142

Date 12-30-96

BOOK 10 PAGE 44