SURVEY & REMONUMENTATION

MAY 28 1997 COMMISSION

# CHIPPEWA COUNTY REMONUMENTATION CORNER

## LAND CORNER RECORDATION CERTIFICATE
**Filing Requirement of Act 74, Mich. P.A. 1970**

$7.00 RECORDING FEE

$2.00 MSSR

3/3/1997 5:18:52 PM Receipt #275
RECEIVED FOR RECORD
CHIPPEWA COUNTY - STATE OF MICHIGAN
SHARON H. KENNEDY, REGISTER OF DEEDS

BOOK 10 PAGE 46

Register of Deeds Stamp & File Number

For corners in Chippewa (County)

| | | Located In: | Corner Code # |
|---|---|---|---|
| 1. Public Land Survey | | T46N R1W | K-6 |
| | | T___ R___ | |
| | | T___ R___ | |
| | | T___ R___ | |
| 2. Property Controlling | S___ | T___ R___ | |
| in Section | S___ | T___ R___ | |
| 3. Miscellaneous | S___ | T___ R___ | |
| Property in Sec. | S___ | T___ R___ | |

4. Lot No. _____ , Recorded Plat _____
5. Private Claims _____

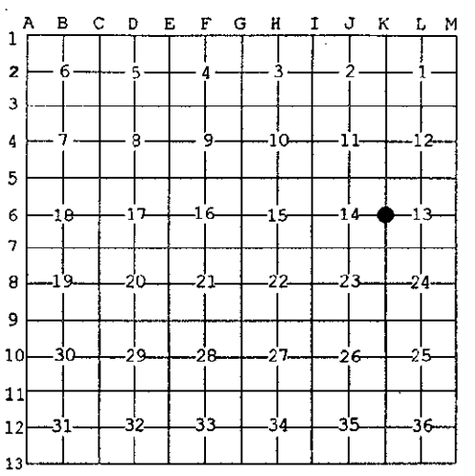


I, Keith R. Waters, in a field survey on 10/31, 19 96 do hereby state that under requirements of P.A. 74, Michigan P.A. of 1970, the corner points mentioned in lines 1 and 2 above were in conformance with regulations and rules therefore as required in the current manual of survey instructions of the United States Department of the Interior, Bureau of Land Management or by a decree of a Court of Law and /or that the corner points mentioned in lines 3, 4 and 5 above were in conformance with the rules of the Michigan Board of Land Surveyors or by a Decree of a Court of Law; established, re-established, monumented, recovered, found as expressed below:

NOTE: **Not more than 2 corners, all in the same town and range, may be recorded on this certificate.**

A. Description of original monument and accessories and/or subsequent restoration:
K-6 1/4 Corner Common to Sections 13 & 14, Town 46 North, Range 1 West
1845 - Original ties (James Mullett): Fir 6, N68°W 30 links - Fir 6, N68°E 17 links.
1902 - County Surveyor Frederick H. Brown notes show the overall mile between Sections 13 and 14 as 5417 feet.

B. Description of corner evidence found and/or method applied in restoring or reestablishing corner:
This corner is being perpetuated as part of the Chippewa County Remonumentation Program.
Found a ½" iron with plastic cap #22428 on the west side of a north-south fence line, at the intersection of a fence line to the east. Found iron is on line between section corners 2745.49 feet north and 2681.56 feet south. Accepted corner as found.

CHIPPEWA COUNTY REMONUMENTATION PEER REVIEW 11/1/96

C. Description of monument for corner and accessories established to perpetuate locating the position of the corner:
Corner is a ½" iron with plastic cap #22428 on the west side of a north-south fence line, at the intersection of a fence line to the east. Witnesses:
7" Balsam Fir, N38°W 8.54'
16" Spruce, S76°W 11.60'
7" White Birch, N70°E 43.15'
6" Balsam Fir, S16°E 17.30'

Note: Distances are to a nail in the side of the tree. Trees are blazed and painted.
Bearings are compass bearings corrected for declination.

STATE OF MICHIGAN KEITH R. WATERS PROFESSIONAL SURVEYOR No. 33142 LICENSED PROFESSIONAL SURVEYOR

Signed by Keith R. Waters Date 12-30-96
Surveyor's Michigan License No. 33142

BOOK 10 PAGE 46

FORM APPROVED BY MICHIGAN STATE BOARD OF PROFESSIONAL SURVEYORS, JAN. 28, 1971
REVISED MAY 14,1975
REVISED JAN., 1983
REVISED OCT., 1995