

MAY 28 1997

COMMISSION

**CHIPPEWA COUNTY REMONUMENTATION CORNER**

**LAND CORNER RECORDATION CERTIFICATE**  
 Filing Requirement of Act 74, Mich. P.A. 1970 \$7.00 RECORDING FEE

For corners in

Chippewa

(County)

Located In:

Corner Code #

1. Public Land Survey

T46N R 1W K-10  
 T R  
 T R  
 T R

2. Property Controlling in Section


S T R  
 S T R

3. Miscellaneous Property in Sec.

S T R  
 S T R

4. Lot No. \_\_\_\_\_, Recorded Plat \_\_\_\_\_

5. Private Claims \_\_\_\_\_

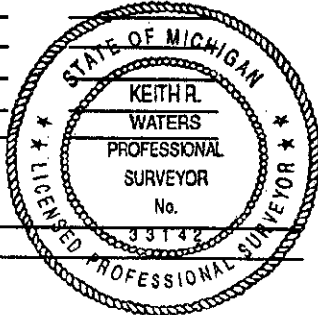

\$2.00 N SSR

3/3/1997 5:19:49 PM Receipt #275  
 RECEIVED FOR RECORD  
 CHIPPEWA COUNTY - STATE OF MICHIGAN  
 SHARON H. KENNEDY, REGISTER OF DEEDS

BOOK 10 PAGE 49  
 Register of Deeds Stamp & File Number

|    | A  | B | C | D  | E | F | G  | H | I | J  | K | L | M  |    |
|----|----|---|---|----|---|---|----|---|---|----|---|---|----|----|
| 1  |    |   |   |    |   |   |    |   |   |    |   |   |    |    |
| 2  | 6  |   |   | 5  |   |   | 4  |   |   | 3  |   |   | 2  | 1  |
| 3  |    |   |   |    |   |   |    |   |   |    |   |   |    |    |
| 4  | 7  |   |   | 8  |   |   | 9  |   |   | 10 |   |   | 11 | 12 |
| 5  |    |   |   |    |   |   |    |   |   |    |   |   |    |    |
| 6  | 18 |   |   | 17 |   |   | 16 |   |   | 15 |   |   | 14 | 13 |
| 7  |    |   |   |    |   |   |    |   |   |    |   |   |    |    |
| 8  | 19 |   |   | 20 |   |   | 21 |   |   | 22 |   |   | 23 | 24 |
| 9  |    |   |   |    |   |   |    |   |   |    |   |   |    |    |
| 10 | 30 |   |   | 29 |   |   | 28 |   |   | 27 |   |   | 26 | 25 |
| 11 |    |   |   |    |   |   |    |   |   |    |   |   |    |    |
| 12 | 31 |   |   | 32 |   |   | 33 |   |   | 34 |   |   | 35 | 36 |
| 13 |    |   |   |    |   |   |    |   |   |    |   |   |    |    |

I, Keith R. Waters, in a field survey on 10/28, 1996 do hereby state that under requirements of P.A. 74, Michigan P.A. of 1970, the corner points mentioned in lines 1 and 2 above were in conformance with regulations and rules therefore as required in the current manual of survey instructions of the United States Department of the Interior, Bureau of Land Management or by a decree of a Court of Law and /or that the corner points mentioned in lines 3, 4 and 5 above were in conformance with the rules of the Michigan Board of Land Surveyors or by a Decree of a Court of Law; established, re-established, monumented, recovered, found as expressed below:

NOTE: Not more than 2 corners, all in the same town and range, may be recorded on this certificate.

**A. Description of original monument and accessories and/or subsequent restoration:**

- K-10 1/4 Corner Common to Sections 25 & 26, Town 46 North, Range 1 West
- 1845 - Original ties (James Mullett): Spruce 20, N55°E 14 links - Spruce 12, S77°W 28 links.
- 1889 - County Surveyor notes (Frederick H. Brown) show distances of 2713 feet to section corner north and 2714 feet to section corner south.
- 1895 - County Surveyor notes (Frederick H. Brown) show distances of 2708 feet to section corners north and south.

**B. Description of corner evidence found and/or method applied in restoring or reestablishing corner:**

This corner is being re-established as part of the Chippewa County Remonumentation Program. Found no evidence of corner. Re-established corner by single proportionate measurement on line between section corners 2712.06 feet north and 2712.06 feet south. Corner location falls on the extension of a fence line to the west and is 33 feet east of remains of an old right-of-way fence on the west side of a north-south seasonal road (Balsam Road).



**C. Description of monument for corner and accessories established to perpetuate locating the position of the corner:**

Corner is a 3/4" x 24" rebar with a plastic Chippewa County Remonumentation cap on the west edge of a north-south seasonal road (Balsam Road), on the extension of an old fence line to the west. Witnesses:  
 Power Pole (D-42), N05°W 219.84'  
 Power Pole (DR2-74-25), S24°W 93.00'  
 5" Spruce, N38°E 41.33'  
 4" Spruce, S79°E 59.26'

Note: Distances are to a nail/tag #33142 in the side of witness object. Bearings are compass bearings corrected for declination. Trees are blazed and painted.

Signed by Keith R. Waters  
 Surveyor's Michigan License No. 33142

Date 12-30-96

BOOK 10 PAGE 49