

SURVEY & REMONUMENTATION
 CHIPPEWA COUNTY REMONUMENTATION CORNER

APR 27 1995

LAND CORNER RECORDATION CERTIFICATE
 Filing Requirement of Act 74, Mich. P.A. 1970

For corners in
Chippewa
 (County)

COMMISSION


Located In:

Corner Code \neq

- | | | | | | |
|------------------------------------|---|------------|---|-----------|------------|
| 1. Public Land Survey | T | <u>46N</u> | R | <u>1W</u> | <u>L-7</u> |
| | T | _____ | R | _____ | _____ |
| | T | _____ | R | _____ | _____ |
| | T | _____ | R | _____ | _____ |
| 2. Property Controlling in Section | S | _____ | T | _____ | _____ |
| | S | _____ | T | _____ | _____ |
| 3. Miscellaneous Property in Sec. | S | _____ | T | _____ | _____ |
| | S | _____ | T | _____ | _____ |
4. Lot No. _____, Recorded Plat _____
5. Private Claims _____

\$ 7.00 LAND CORNER
 \$ 2.00 HSSR
 19 DEC 94 10:18 A.M. RECEIPT# 1769
 RECEIVED FOR RECORD
 CHIPPEWA COUNTY - STATE OF MICHIGAN
 SHARON H. KENNEDY, REGISTER OF DEEDS

Register of Deeds Stamp & File Number

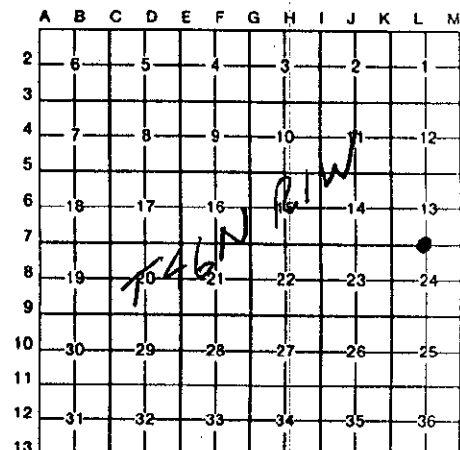

I, William L. Karr, in a field survey on October 19, 1994, do hereby certify that under requirements of P.A. 74, Michigan P.A. of 1970, the corner points mentioned in lines 1 and 2 above were in conformance with regulations and rules therefore as required in the current manual of survey instructions of the United States Department of the Interior, Bureau of Land Management or by a decree of a Court of Law and/or that the corner points mentioned in lines 3, 4 and 5 above were in conformance with the rules of the Michigan Board of Land Surveyors or by a Decree of a Court of Law; established, re-established, monumented, re-monumented, recovered, found as expressed below:

NOTE: Not more than 4 corners, all in the same town and range, may be recorded on this certificate.

A. Description of original monument and accessories and/or subsequent restoration:

(L-7) 1/4 Corner Sections 13 & 24, T.46 N., R.1 W.

1845: J. Mullett set 1/4 sec post Spruce 4 N10E 29 lks
 Spruce 6 S14W 43 lks

1897: County Surveyor notes show the Section line as measuring 5274' (5269.76' today).

B. Description of corner evidence found and/or method applied in restoring or reestablishing corner:


(L-7) This corner is being perpetuated as part of the Chippewa County Remonumentation program.

Found no evidence of original corner. Found a 3/4" iron in a monument box on the extension of fencelines to the North and South and on a straight line between Section corners. The found corner is on an even split of the mile, (2634.88' for each 1/2 mile). I do not know the origin of the monument box or the iron. I accepted the position as found since it is on an even split of the mile, on the extension of fences to the North and South and on a straight line between Section corners.

C. Description of monument for corner and accessories established to perpetuate locating the position of the corner:

(L-7) Corner is a 3/4"x 24" iron with plastic "Chippewa County Remonumentation" cap in a monument box. Corner falls on the centerline of M-28 and on the extension of fences to the North and South.

Witnesses: 2nd Post North of fence corner	North	57.77'
3rd Post East of fence corner	N21°E	54.36'
4th Post East of fence corner	S41°E	66.20'
P. Pole (DR1/35)	S07°W	49.72'

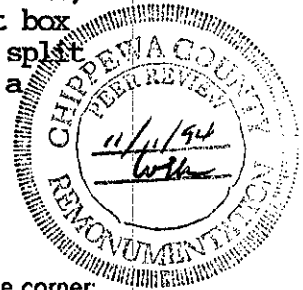

Signed by William L. Karr Date 12/7/94

Surveyor's Michigan License No. 27450

723-12

NOTE: Bearings are compass bearings corrected for declination. Distances are to a nail in side of witness objects unless noted.