

1993

COMMISSION

CHIPPEWA COUNTY REMONUMENTATION CORNER

RECEIVED FOR RECORD  
CHIPPEWA COUNTY  
STATE OF MICHIGAN

LAND CORNER RECORDATION CERTIFICATE  
Filing Requirement of Act 74, Mich. P.A. 1970

93 DEC -3 PM 3: 58

For corners in  
Chippewa

(County)

Located In:

Corner Code ~~##~~

- 1. Public Land Survey  
T 46N R 1E A-2 Same  
T 46N R 1W M-2 Corner
- 2. Property Controlling  
S \_\_\_ T \_\_\_ R \_\_\_
- 3. Miscellaneous  
S \_\_\_ T \_\_\_ R \_\_\_
- Property in Sec. \*S \_\_\_ T \_\_\_ R \_\_\_

*J. Roger Malott*  
REGISTER OF DEEDS

Register of Deeds Stamp & File Number

- 4. Lot No. \_\_\_\_\_, Recorded Plat \_\_\_\_\_
- 5. Private Claims \_\_\_\_\_

I, Keith R. Waters in a field survey on October 28, 19 93, do hereby certify that under requirements of P.A. 74, Michigan P.A. of 1970, the corner points mentioned in lines 1 and 2 above were in conformance with regulations and rules therefore as required in the current manual of survey instructions of the United States Department of the Interior, Bureau of Land Management or by a decree of a Court of Law and/or that the corner points mentioned in lines 3, 4 and 5 above were in conformance with the rules of the Michigan Board of Land Surveyors or by a Decree of a Court of Law; established, re-established, monumented, re-monumented, recovered, found as expressed below:

NOTE: Not more than 4 corners, all in the same town and range, may be recorded on this certificate.

A. Description of original monument and accessories and/or subsequent restoration:

A-2 (T46N, R1E)  
1/4 Corner Common to Section 6, T46N, R1E & Section 1, T46N, R1W

Original ties to set post (Wm. A. Burt, D.S., 1840):

- Birch 14, S14°W 33 links
- Birch 16, N22°W 65 links



B. Description of corner evidence found and/or method applied in restoring or reestablishing corner:

A-2 (T46N, R1E)  
This corner is being re-established as part of the Chippewa County Remonumentation Program.  
Found no evidence of corner or its accessories. Re-established corner on line between Section corners 2655.98 feet north and 2655.98 feet south. Corner is on line with recorded corners at the center of Section 6 and the East 1/4 corner of Section 6, T46N, R1E. Corner falls on the south side of the base of a fallen over fence post at the intersection of old fences north, south, east and west.

C. Description of monument for corner and accessories established to perpetuate locating the position of the corner:

A-2 (T46N, R1E)  
Corner is a 3/4" x 24" rebar with a 3 1/4" aluminum Chippewa County Remonumentation cap on the south side of the base of a fence post at intersection of fences north, south, east, and west. Witnesses:  
4" Spruce, N02°W 36.52'  
5" Spruce, N65°E 136.08'  
3" Aspen, N55°W 78.29'  
Center of Section 6, EAST 2687.58'  
NW Corner Section 6, NORTH 2655.98'  
SW Corner Section 6, SOUTH 2655.98'

Note: Distances are to a nail and tag in the side of trees. Trees are blazed and painted. Bearings are compass bearings corrected for declination.

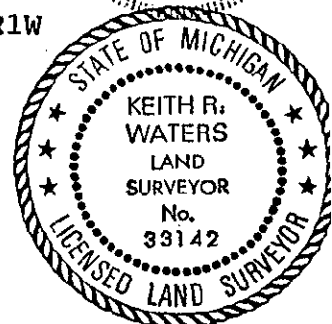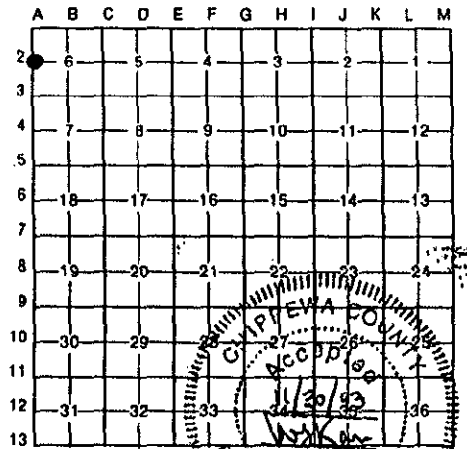

Signed by Keith R. Waters Date 11-30-93

Surveyor's Michigan License No. 33142