

1993

CHIPPEWA COUNTY REMONUMENTATION CORNER

RECEIVED FOR RECORD
CHIPPEWA COUNTY
STATE OF MICHIGAN

COMMISSION

LAND CORNER RECORDATION CERTIFICATE

Filing Requirement of Act 74, Mich. P.A. 1970

93 DEC -3 PM 3: 59

For corners in

Chippewa

(County)

Located In:

Corner Code #

1. Public Land Survey	T 46N R 1E	A-5 Same
	T 46N R 1W	M-5 Corner
	T _____ R _____	
	T _____ R _____	
2. Property Controlling in Section	S _____ T _____ R _____	
	S _____ T _____ R _____	
3. Miscellaneous Property in Sec.	S _____ T _____ R _____	
	S _____ T _____ R _____	

J. Roger Malott

REGISTER OF DEEDS

Register of Deeds Stamp & File Number

4. Lot No. _____, Recorded Plat _____
5. Private Claims _____

I, Keith R. Waters in a field survey on August 31, 19 93, do hereby certify that under requirements of P.A. 74, Michigan P.A. of 1970, the corner points mentioned in lines 1 and 2 above were in conformance with regulations and rules therefore as required in the current manual of survey instructions of the United States Department of the Interior, Bureau of Land Management or by a decree of a Court of Law and/or that the corner points mentioned in lines 3, 4 and 5 above were in conformance with the rules of the Michigan Board of Land Surveyors or by a Decree of a Court of Law; established, re-established, monumented, re-monumented, recovered, found as expressed below:

NOTE: Not more than 4 corners, all in the same town and range, may be recorded on this certificate.

A. Description of original monument and accessories and/or subsequent restoration:

A-5 (T46N, R1E)

Section Corner Common to Sections 7 & 18, T46N, R1E & Sections 12 & 13, T46N, R1W). (1986)

This corner is recorded by Larry R. Rogers, P.S. 29251, in liber 6, page 289, of Chippewa County corner records as a 1 1/4" iron pipe with the following ties:

- NE Corner House, S55°W 174.39' Corner Fence Post, South 31.80'
- Corner Fence Post, N03°E 89.52' Fence Post, North 26.50'
- 6" Aspen, S56°E 107.06'

B. Description of corner evidence found and/or method applied in restoring or reestablishing corner:

A-5 (T46N, R1E)

This corner is being perpetuated as part of the Chippewa County Remonumentation Program.

Found a 1 1/4" iron pipe approximately 5 feet north of centerline of east-west gravel road (8 Mile Road). Position checks with two remaining witnesses from 1986 records (house corner and fence post). 6" aspen is dead and fallen over. Accepted corner as found and established new witness objects.


C. Description of monument for corner and accessories established to perpetuate locating the position of the corner:

A-5 (T46N, R1E)

Corner is a 1 1/4" iron pipe approximately 5' north of centerline of east-west gravel road (8 Mile Road). Witnesses:

- 8" Aspen, S42°E 109.54'
- Twin 4"-7" Spruce, S23°E 109.57'
- N.E. Corner House, S55°W 174.53'
- Corner Fence Post, N03°E 89.56'

Note: Distances are to a nail and tag in the side of witness object. Bearings are compass bearings corrected for declination. Distances are measured with EDM. Trees are blazed and painted.

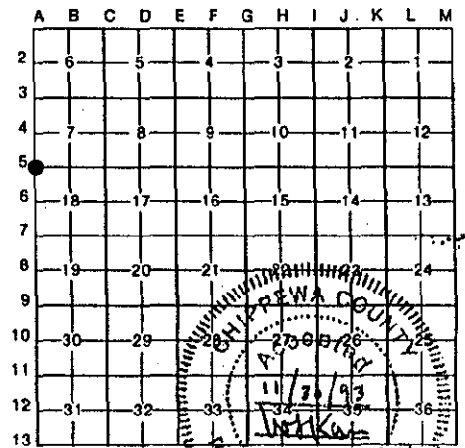

Signed by Keith R. Waters

Date 11-30-93

Surveyor's Michigan License No. 33142