

1993 CHIPPEWA COUNTY REMONUMENTATION CORNER

RECEIVED FOR RECORD  
CHIPPEWA COUNTY  
STATE OF MICHIGAN

COMMISSION

LAND CORNER RECORDATION CERTIFICATE

Filing Requirement of Act 74, Mich. P.A. 1970

93 DEC -3 PM 3: 59

For corners in

Chippewa

(County)

Located In:

Corner Code ##


- 1. Public Land Survey  
T46N R 1E  
T46N R 1W  
T R  
T R  
T R
- 2. Property Controlling in Section  
S T R  
S T R
- 3. Miscellaneous Property In Sec.  
S T R  
S T R

A-9 Same  
M-9 Corner

J. Roger Malott  
REGISTER OF DEEDS

Register of Deeds Stamp & File Number

- 4. Lot No. \_\_\_\_\_, Recorded Plat \_\_\_\_\_
- 5. Private Claims \_\_\_\_\_

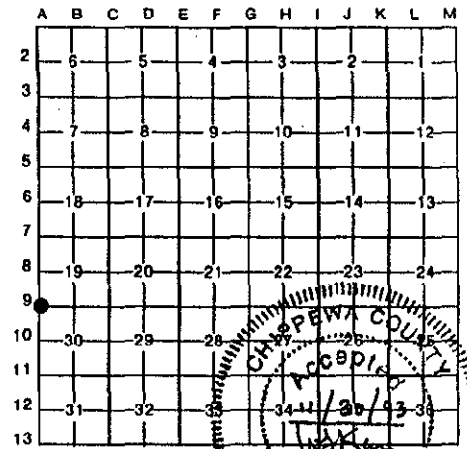

I, Keith R. Waters in a field survey on June 14, 19 93, do hereby certify that under requirements of P.A. 74, Michigan P.A. of 1970, the corner points mentioned in lines 1 and 2 above were in conformance with regulations and rules therefore as required in the current manual of survey instructions of the United States Department of the Interior, Bureau of Land Management or by a decree of a Court of Law and/or that the corner points mentioned in lines 3, 4 and 5 above were in conformance with the rules of the Michigan Board of Land Surveyors or by a Decree of a Court of Law; established, re-established, monumented, re-monumented, recovered, found as expressed below:

NOTE: Not more than 4 corners, all in the same town and range, may be recorded on this certificate.

A. Description of original monument and accessories and/or subsequent restoration:

A-9 (T46N, R1E)  
Section Corner Common to Sections 19 & 30, T46N, R1E, and Sections 24 & 25, T46N, R1W.

Michigan State Highway Department (11-29-65) as recorded in liber 2, page 246, of Chippewa County corner records: Found 1/2" reinforcing rod in monument box with the following ties: Guard Post, S50°W 25.62'  
Guard Post, S35°E 34.57'  
Guard Post, N60°E 49.06'


B. Description of corner evidence found and/or method applied in restoring or reestablishing corner:

A-9 (T46N, R1E)  
This corner is being perpetuated as part of the Chippewa County Remonumentation Program.  
Found a 1/2" iron pin in a monument box 1.5' east of centerline of Highway M-129 at the intersection of 10 Mile Road. All witnesses from Highway Department records are gone. Distance to 1/4 corner 1/2 mile south checks well with that as shown on Highway Department records. Accepted corner found and established four new witness objects.

C. Description of monument for corner and accessories established to perpetuate locating the position of the corner:  
A-9 (T46N, R1E)  
Corner is a 1/2" iron pin in a monument box 1.5' east of centerline of Highway M-129 at the intersection of 10 Mile Road.

- Witnesses:
- P. Pole (DR2-58), N23°E 207.60'
  - P. Pole (DR2-57-1), N78°E 176.39'
  - P. Pole, S46°E 102.83'
  - Nail/tag in top of wood guard post at end of culvert, S26°E 91.43'
  - Nail/tag in top of wood guard post at end of culvert, S68°W 77.78'

Note: Unless noted otherwise, distances to a nail and tag in the side of the witness object. Bearings are compass bearings corrected for declination. Distances measured with EDM.

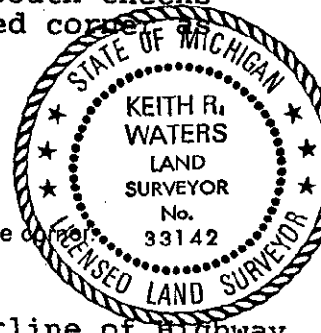

Signed by Keith R. Waters

Date 11-30-93

Surveyor's Michigan License No. 33142