

1993

CHIPPEWA COUNTY REMONUMENTATION CORNER

RECEIVED FOR RECORD  
CHIPPEWA COUNTY  
STATE OF MICHIGAN

COMMISSION

LAND CORNER RECORDATION CERTIFICATE

Filing Requirement of Act 74, Mich. P.A. 1970

93 DEC -3 PM 3: 59

For corners in  
Chippewa

(County)

Located In:

Corner Code #


1. Public Land Survey	T 46N R 1E	A-11 Same
	T 46N R 1W	M-11 Corner
	T _____ R _____	
	T _____ R _____	
2. Property Controlling in Section	S _____ T _____ R _____	
	S _____ T _____ R _____	
3. Miscellaneous Property in Sec.	S _____ T _____ R _____	
	S _____ T _____ R _____	

*J. Roger Matlock*  
REGISTER OF DEEDS

Register of Deeds Stamp & File Number

4. Lot No. \_\_\_\_\_, Recorded Plat \_\_\_\_\_  
5. Private Claims \_\_\_\_\_

I, Keith R. Waters, in a field survey on June 14, 19 93, do hereby certify that under requirements of P.A. 74, Michigan P.A. of 1970, the corner points mentioned in lines 1 and 2 above were in conformance with regulations and rules therefore as required in the current manual of survey instructions of the United States Department of the Interior, Bureau of Land Management or by a decree of a Court of Law and/or that the corner points mentioned in lines 3, 4 and 5 above were in conformance with the rules of the Michigan Board of Land Surveyors or by a Decree of a Court of Law; established, re-established, monumented, re-monumented, recovered, found as expressed below:

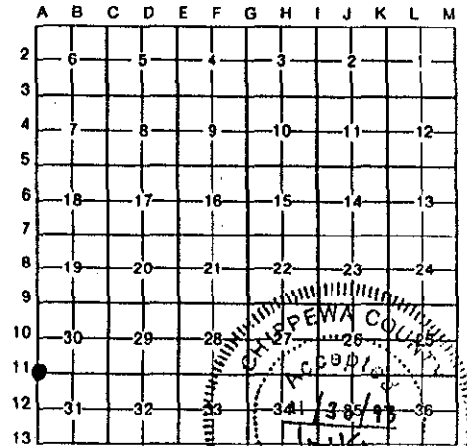

NOTE: Not more than 4 corners, all in the same town and range, may be recorded on this certificate.

A. Description of original monument and accessories and/or subsequent restoration:

A-11 (T46N, R1E)  
Section Corner Common to Sections 30 & 31, T46N, R1E and Sections 25 & 26, T46N, R1W.

Michigan State Highway Department (11-29-65) as recorded in liber 2, page 219, of Chippewa County corner records: Found 3/4" iron bolt in monument box with the following ties: T. Pole, N60°W 71.98'  
Mail Box, S30°W 34.69'  
P. Pole, N70°E 79.31'

B. Description of corner evidence found and/or method applied in restoring or reestablishing corner:

A-11 (T46N, R1E)  
This corner is being perpetuated as part of the Chippewa County Remonumentation Program.  
Found a 1/2" iron pin in a monument box in the centerline of Highway M-129 at the intersection of 11 Mile Road. (Monument box cover is broken). Distances to 1/4 corner 1/2 mile north and to Township corner 1 mile south check closely with those as shown on Highway Department records. All witnesses shown by Highway Department are gone. Accepted corner as found and established new witness objects.

C. Description of monument for corner and accessories established to perpetuate locating the position of the corner:

A-11 (T46N, R1E)  
Corner is a 1/2" iron pin in a monument box in centerline of Highway M-129 intersection of 11 Mile Road.  
Witnesses:  
Power Pole (DR2-73), N23°E 216.43'  
Power Pole (DR2-74), S25°E 174.32'  
Telephone Pole (8-294), S29°W 139.82'  
Power Pole (DR2-74-1), N32°W 112.92'  
NW Corner of 2 Story Frame House, S46°E 154.87'

Note: Unless noted otherwise, distances are to a nail and tag in the side of witness object. Bearings are compass bearings corrected for declination. Distances measured with EDM.



Signed by Keith R. Waters

Date 11-30-93

Surveyor's Michigan License No. 33142