

1999

LAND CORNER RECORDATION CERTIFICATE
Filing Requirement of Act 74, Mich. P.A. 1970
Chippewa County Remonumentation Corner

For corners in SECTION

Chippewa

Located In:

Corner Code #

- | | | | | |
|------------------------------------|------|-------|------|-------|
| 1. Public Land Survey | SAME | T 46N | R 2E | B-1 ✓ |
| CORNER | | T 47N | R 2E | B-13 |
| | | T | R | |
| | | T | R | |
| 2. Property Controlling in Section | S | T | R | |
| | S | T | R | |
| 3. Miscellaneous Property in Sec. | S | T | R | |
| | S | T | R | |

\$7.00 LAND CORNER

\$2.00 MSSR

21 JAN 1999 10:34:50 AM Receipt #13123

RECEIVED FOR RECORD

CHIPPewa COUNTY - STATE OF MICHIGAN
SHARON H. KENNEDY, REGISTER OF DEEDS

BOOK 10 PAGE 360

Register of Deeds Stamp & File Number

4. Lot No. _____, Recorded Plat _____
5. Private Claims _____

I, Larry R. Rogers in a field survey on December 24, 1998, do hereby state that under requirements of P.A. 74, Michigan P.A. of 1970, the corner points mentioned in lines 1 and 2 above were in conformance with regulations and rules therefore as required in the current manual of survey instructions of the United States Department of the Interior, Bureau of Land Management or by a decree of a Court of Law and/or that the corner points mentioned in lines 3, 4 and 5 above were in conformance with the rules of the Michigan Board of Land Surveyors or by a Decree of a Court of Law; established, re-established, monumented, recovered, found as expressed below:

NOTE: Not more than 2 corners, all in the same town and range, may be recorded on this certificate.

1	A	B	C	D	E	F	G	H	I	J	K	L	M
2		6	5			4		3		2		1	
3													
4		7		8		9		10		11		12	
5													
6		18		17		16		15		14		13	
7													
8		19		20		21		22		23		24	
9													
10		30		29		28		27		26		25	
11													
12		31		32		33		34		35		36	
13													

A. Description of original monument and accessories and/or subsequent restoration:


(B-1) North 1/4 Corner Section 6, Township 46 North, Range 2 East.

Original corner post was placed in 1845 by John Mullett. In 1919 County Surveyor Brown set post and bolt from original bearing tree. Early 1970's survey by N.D. Alix found a 3/4" bolt. A 1975 Dependent Resurvey by the Bureau of Land Management found a 1/2" iron pin below the surface of an East-West County Road (Six Mile Road). In 1981 William L. Karr, P.S. 27450 found 1" iron bar that matched location of B.L.M. Resurvey and filed a L.C.R.C. in Liber 5, Page 73 of the Chippewa County Corner Records.

B. Description of corner evidence found and/or method applied in restoring or reestablishing corner:

(B-1) North 1/4 Corner Section 6, Township 46 North, Range 2 East.


This corner is being perpetuated as part of the Chippewa County Remonumentation Program. Found 1" iron as recorded by Karr and one remaining witness. Accepted corner position as found. Distance East to Section Corner is 2620.38 feet (B.L.M. Resurvey = 2619.54 feet).

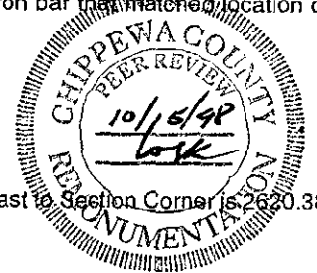

C. Description of monument for corner and accessories established to perpetuate locating the position of the corner:

B-1 North 1/4 corner Section 6, Township 46 North, Range 2 East.

Corner is a 1" iron pin 2 feet South of centerline of Six Mile Road (East-West, gravel).

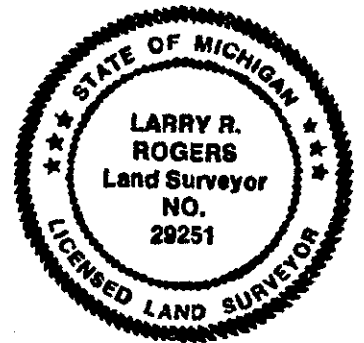

Witnesses:		
12" Basswood	N45°E	40.89 feet
6" Spruce	N61°W	143.50 feet
Utility Pole (SU1/106/1)	S67°W	62.84 feet
12" Maple in clump	S41°W	98.94 feet

Signed by _____ Date 30 DEC 1998

Surveyor's Michigan License No. 29251

NOTE: All bearings are compass bearings corrected for declination (6°W). All distances are to a nail and tag in the side of witness object unless otherwise noted.