

1939

LAND CORNER RECORDATION CERTIFICATE  
Filing Requirement of Act 74, Mich. P.A. 1970  
Chippewa County Remonumentation Corner

SECTION

For corners in

Chippewa	Located In:	Corner Code #
1. Public Land Survey	T <u>46N</u> R <u>2E</u>	<u>B-3</u>
	T ___ R ___	_____
	T ___ R ___	_____
	T ___ R ___	_____
2. Property Controlling in Section	S ___ T ___ R ___	
	S ___ T ___ R ___	
3. Miscellaneous Property in Sec.	S ___ T ___ R ___	
	S ___ T ___ R ___	

\$7.00 LAND CORNER  
\$2.00 MSSR  
21 JAN 1999 10:24:48 AM Receipt #13123  
RECEIVED FOR RECORD  
CHIPPEWA COUNTY - STATE OF MICHIGAN  
SHARON H. KENNEDY, REGISTER OF DEEDS

BOOK **10** PAGE **348**  
Register of Deeds Stamp & File Number

4. Lot No. \_\_\_\_\_, Recorded Plat \_\_\_\_\_  
5. Private Claims \_\_\_\_\_


1	A	B	C	D	E	F	G	H	I	J	K	L	M
2		6		5		4		3		2		1	
3		●											
4		7		8		9		10		11		12	
5													
6		18		17		16		15		14		13	
7													
8		19		20		21		22		23		24	
9													
10		30		29		28		27		26		25	
11													
12		31		32		33		34		35		36	
13													

I, Larry R. Rogers in a field survey on October 15, 1998, do hereby state that under requirements of P.A. 74, Michigan P.A. of 1970, the corner points mentioned in lines 1 and 2 above were in conformance with regulations and rules therefore as required in the current manual of survey instructions of the United States Department of the Interior, Bureau of Land Management or by a decree of a Court of Law and/or that the corner points mentioned in lines 3, 4 and 5 above were in conformance with the rules of the Michigan Board of Land Surveyors or by a Decree of a Court of Law; established, re-established, monumented, recovered, found as expressed below:

NOTE: Not more than 2 corners, all in the same town and range, may be recorded on this certificate.

A. Description of original monument and accessories and/or subsequent restoration:  
(B-3) 1/4 Corner Common to Sections 6 and 7, Township 46 North, Range 2 East.

The original corner was placed in 1845 by James H. Mullett. County Surveyor records make no specific reference to corner. In 1975, a B.L.M. dependent re-survey found no corner and re-established the corner position "latitudinally by the centerline of a dirt road, bears E. and W. and longitudinally at record distance". In 1981, William L. Karr, P.S. 27450 recovered B.L.M. pipe with brass cap, 13 feet South of centerline of East-West road and also recovered two B.L.M. witness trees. Contrary to B.L.M. survey notes, the corner was apparently NOT placed in the centerline of the road. Karr filed a L.C.R.C. in Liber 5, Page 076 of the Chippewa County Corner Records.

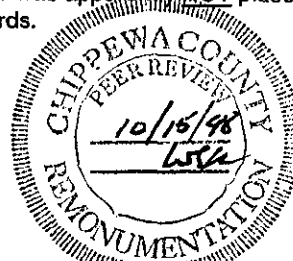


B. Description of corner evidence found and/or method applied in restoring or reestablishing corner:  
(B-3) 1/4 Corner Common to Sections 6 and 7, Township 46 North, Range 2 East.

This corner is being perpetuated as part of the Chippewa County Remonumentation Program. Found 2 1/2" iron pipe with stamped brass cap as placed by B.L.M. resurvey, 4 feet South of the South edge of East-West gravel road (7 Mile Road). Recovered two B.L.M. balsam fir witness trees that match corner reasonably well. Accepted corner as found and added two new witnesses.

C. Description of monument for corner and accessories established to perpetuate locating the position of the corner:  
(B-3) 1/4 Corner Common to Sections 6 and 7, Township 46 North, Range 2 East.

Corner is a B.L.M. 2 1/2" iron pipe with stamped brass cap, 4 feet South of South edge of Seven Mile Road.

Witnesses:  
8" Balsam Fir S29°W 13.89 feet (B.L.M. 14.52 feet)  
10" Balsam Fir S34°E 16.17 feet (B.L.M. 15.84 feet)  
15" Spruce N23°W 84.04 feet  
15" Oak N34°E 87.55 feet

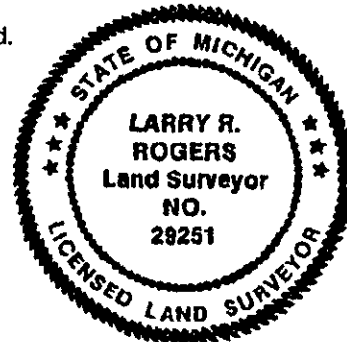

Signed by [Signature] Date 30 DEC 1998

Surveyor's Michigan License No. 29251

NOTE: All bearings are compass bearings corrected for declination (6°W). All distances are to a nail and tag in the side of witness object unless otherwise noted.