

MAR 18 1999

LAND CORNER RECORDATION CERTIFICATE
Filing Requirement of Act 74, Mich. P.A. 1970
Chippewa County Remonumentation Corner

For corners in

SECTION

Chippewa

Located In:

Corner Code #

1. Public Land Survey

SAME

CORNER

Table with columns T, R and rows 46N, 47N, 48N, 49N, 50N, 51N, 52N

C-1
C-13

2. Property Controlling in Section

3. Miscellaneous Property in Sec.

Table with columns S, T, R and rows 1, 2, 3, 4, 5, 6, 7, 8, 9, 10, 11, 12, 13, 14, 15, 16, 17, 18, 19, 20, 21, 22, 23, 24, 25, 26, 27, 28, 29, 30, 31, 32, 33, 34, 35, 36

4. Lot No. Recorded Plat

5. Private Claims

\$7.00 LAND CORNER
\$2.00 HSSR
21 JAN 1999 10:18:24 AM Receipt #13123
RECEIVED FOR RECORD
CHIPPewa COUNTY - STATE OF MICHIGAN
SHARON H. KENNEDY, REGISTER OF DEEDS

BOOK 10 PAGE 341

Register of Deeds Stamp & File Number

I, Larry R. Rogers in a field survey on March 18, 1998, do hereby state that under requirements of P.A. 74, Michigan P.A. of 1970, the corner points mentioned in lines 1 and 2 above were in conformance with regulations and rules therefore as required in the current manual of survey instructions of the United States Department of the Interior, Bureau of Land Management or by a decree of a Court of Law and/or that the corner points mentioned in lines 3, 4 and 5 above were in conformance with the rules of the Michigan Board of Land Surveyors or by a Decree of a Court of Law; established, re-established, monumented, recovered, found as expressed below:

NOTE: Not more than 2 corners, all in the same town and range, may be recorded on this certificate.

Grid table with columns A-M and rows 1-13. Contains handwritten numbers and letters like 'E', 'R', 'N', 'H', 'A'.

A. Description of original monument and accessories and/or subsequent restoration:
(C-1) Northeast Corner of Section 6, Township 46 North, Range 2 East.

The original corner was placed in 1845 by John Mullett. County Surveyor notes make no specific mention of corner. 1975 B.L.M. dependent re-survey found and accepted a 1/2" iron pin but left no witnesses. In 1981, William L. Karr, P.S. 27450 found a 1" iron pipe that checked with B.L.M. distances to corners East, West and South. Karr filed a L.C.R.C. in Liber 5, Page 073 of the Chippewa County Records.

B. Description of corner evidence found and/or method applied in restoring or reestablishing corner:
(C-1) Northeast Corner of Section 6, Township 46 North, Range 2 East.

This corner is being perpetuated as part of the Chippewa County Remonumentation Program. Found 1" iron pipe with P.K. nail in center on the North edge of Six Mile Road (East-West, gravel) and on the centerline of Homestead Road (gravel) to the North. Distances to 1/4 corner West is 2620.38 feet (2619.54 feet B.L.M.), to 1/4 Corner East is 2620.44 feet (2620.20 B.L.M.) and to 1/4 Corner South is 2641.18 feet (2641.32 B.L.M.) Accepted corner position as found.

C. Description of monument for corner and accessories established to perpetuate locating the position of the corner:
(C-1) Northeast Corner of Section 6, Township 46 North, Range 2 East.


Corner is a 1" iron pipe with broken top and P.K. nail set in center, on the North edge of Six Mile Road and the centerline of Homestead Road to North.

Witnesses:

Table with columns: Witness, Bearing, Distance. Includes 16" White Pine, 4" Aspen, 11" Red Oak, Utility Pole.

Signed by [Signature]

Date 30 DEC 1998

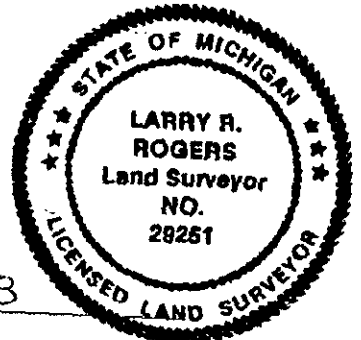

Surveyor's Michigan License No. 29251

NOTE: All bearings are compass bearings corrected for declination (6"W). All distances are to a nail and tag in the side of witness object unless otherwise noted.