

1899

LAND CORNER RECORDATION CERTIFICATE
 Filing Requirement of Act 74, Mich. P.A. 1970
 Chippewa County Remonumentation Corner

For corners in SECTION


<u>Chippewa</u>	Located In:	Corner Code #
1. Public Land Survey	T <u>46N</u> R <u>2E</u>	<u>C-2</u>
	T _____ R _____	_____
	T _____ R _____	_____
	T _____ R _____	_____
2. Property Controlling in Section	S _____ T _____ R _____	
	S _____ T _____ R _____	
3. Miscellaneous Property in Sec.	S _____ T _____ R _____	
	S _____ T _____ R _____	
4. Lot No. _____, Recorded Plat _____		
5. Private Claims _____		

\$7.00 LAND CORNER
 \$2.00 MSSR
 21 JAN 1999 10:21:11 AM Receipt #13123
 RECEIVED FOR RECORD
 CHIPPEWA COUNTY - STATE OF MICHIGAN
 SHARON H. KENNEDY, REGISTER OF DEEDS

BOOK 10 PAGE 345
 Register of Deeds Stamp & File Number

I, Larry R. Rogers in a field survey on October 20, 1998, do hereby state that under requirements of P.A. 74, Michigan P.A. of 1970, the corner points mentioned in lines 1 and 2 above were in conformance with regulations and rules therefore as required in the current manual of survey instructions of the United States Department of the Interior, Bureau of Land Management or by a decree of a Court of Law and/or that the corner points mentioned in lines 3, 4 and 5 above were in conformance with the rules of the Michigan Board of Land Surveyors or by a Decree of a Court of Law; established, re-established, monumented, recovered, found as expressed below:

NOTE: Not more than 2 corners, all in the same town and range, may be recorded on this certificate.

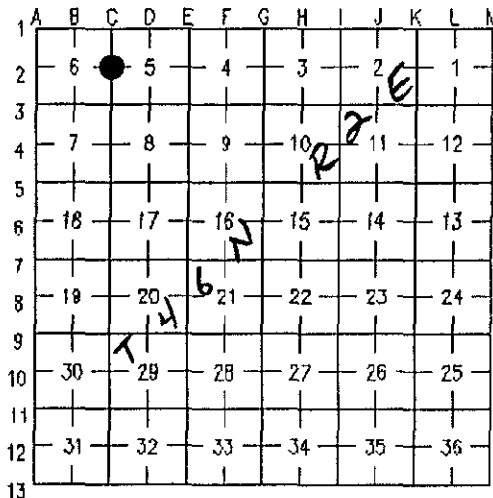

A. Description of original monument and accessories and/or subsequent restoration:
(C-2) 1/4 Corner Common to Sections 5 and 6, Township 46 North, Range 2 East.

The original corner was a 12" Hemlock marked in 1845 by James H. Mullett. County Surveyor records make no specific reference to corner. In a 1975 B.L.M. dependent resurvey the corner was re-established midway and on line between the Northeast and Southeast corners of Section 6.


B. Description of corner evidence found and/or method applied in restoring or reestablishing corner:
(C-2) 1/4 Corner Common to Sections 5 and 6, Township 46 North, Range 2 East.

This corner is being perpetuated as part of the Chippewa County Remonumentation Program. Found brass capped iron pipe set by B.L.M. in 1975 at Northwest edge of 12" Yellow Birch stump. Distance to the Northeast corner of Section 6 is 2641.18 feet (2641.32 feet B.L.M.) and distance to Southeast corner of Section 6 is 2641.08 feet (2641.32 B.L.M.) Corner falls 1.5 feet East of a straight line between Northeast and Southeast corners of Section 6. Accepted corner position as found and established new witnesses.

C. Description of monument for corner and accessories established to perpetuate locating the position of the corner:
(C-2) 1/4 Corner Common to Sections 5 and 6, Township 46 North, Range 2 East.

Corner is a B.L.M. brass capped 2 1/2" diameter iron pipe.

Witnesses:		
6" Balsam Fir	N17°E	9.26 feet
12" Maple	N88°E	12.61 feet
16" Elm	S45°W	15.52 feet
8" Maple	S86°W	9.38 feet
Steel Fence Post	North	2.0 feet

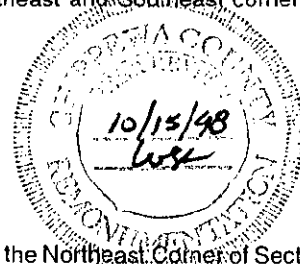

Signed by [Signature] Date 30 DEC 1998

Surveyor's Michigan License No. 29251

NOTE: All bearings are compass bearings corrected for declination (6°W). All distances are to a nail and tag in the side of witness object unless otherwise noted.