

1999

LAND CORNER RECORDATION CERTIFICATE
 Filing Requirement of Act 74, Mich. P.A. 1970
 Chippewa County Remonumentation Corner

For corners in SECTION

Chippewa Located In: Corner Code #

1. Public Land Survey T 46N R 2E C-3
 T ___ R ___
 T ___ R ___
 T ___ R ___

2. Property Controlling S ___ T ___ R ___
 in Section S ___ T ___ R ___

3. Miscellaneous S ___ T ___ R ___
 Property in Sec. S ___ T ___ R ___


\$7.00 LAND CORNER
 \$2.00 HSSR
 21 JAN 1999 10:25:21 AM Receipt #13123
 RECEIVED FOR RECORD
 CHIPPEWA COUNTY - STATE OF MICHIGAN
 SHARON H. KENNEDY, REGISTER OF DEEDS

BOOK **10** PAGE **349**
 Register of Deeds Stamp & File Number

4. Lot No. _____, Recorded Plat _____
 5. Private Claims _____

I, Larry R. Rogers in a field survey on October 15, 1998, do hereby state that under requirements of P.A. 74, Michigan P.A. of 1970, the corner points mentioned in lines 1 and 2 above were in conformance with regulations and rules therefore as required in the current manual of survey instructions of the United States Department of the Interior, Bureau of Land Management or by a decree of a Court of Law and/or that the corner points mentioned in lines 3, 4 and 5 above were in conformance with the rules of the Michigan Board of Land Surveyors or by a Decree of a Court of Law; established, re-established, monumented, recovered, found as expressed below:

NOTE: Not more than 2 corners, all in the same town and range, may be recorded on this certificate.

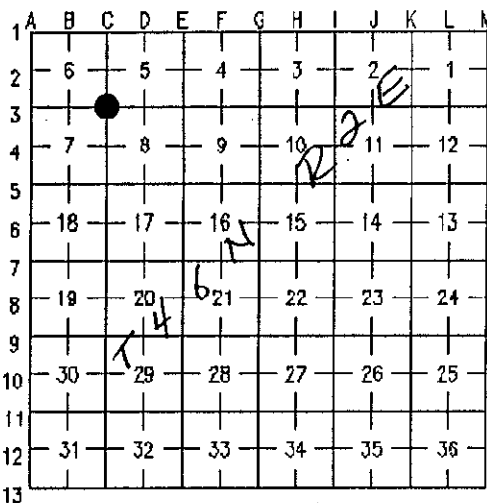

A. Description of original monument and accessories and/or subsequent restoration:
(C-3) Northeast corner of Section 7, Township 46 North, Range 2 East.

The original corner was placed in 1845 by James H. Mullett. County Surveyor notes make no specific reference to this corner. In a 1975 dependent resurvey the B.L.M. did not find a corner. They re-established the corner position "latitudinally at the center line of a gravel road, bears E. and W. and longitudinally on the projection of a blazed line to the S." In 1976, James Granger found B.L.M. brass capped pipe and filed a L.C.R.C. in Liber 1, Page 206 of the Chippewa County Corner Records. A second L.C.R.C. was filed in Liber 1, Page 254 to correct a witness tree bearing. The spruce witness trees on Granger corner forms are actually the B.L.M. balsam fir witness trees. Corner was subsequently hit and removed by county plow. Corner position was re-established by Larry R. Rogers, P.S. 29251 in 1997 from three previous witnesses-dead, but still standing.

B. Description of corner evidence found and/or method applied in restoring or reestablishing corner:
(C-3) Northeast Corner of Section 7, Township 46 North, Range 2 East.


This corner is being perpetuated as part of the Chippewa County Remonumentation Program. Found 1/2" iron pin with P.S. cap 29251 in centerline of East - West gravel road. Corner matches three standing (dead) bearing trees from B.L.M./Granger surveys. Accepted corner position as found and established four new witnesses.

C. Description of monument for corner and accessories established to perpetuate locating the position of the corner:
(C-3) Northeast Corner of Section 7, Township 46 North, Range 2 East.

Corner is a 1/2" x 24" iron with P.S. cap 29251 buried 4" below grade and in centerline of East - West gravel road (Seven Mile Road).

Witnesses:

10" Spruce	S51°E	41.59 feet
10" Triple Maple	N24°E	56.62 feet
6" Quad Maple	N70°W	61.85 feet
8" Poplar	S54°W	46.83 feet

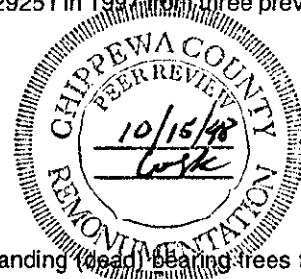

Signed by [Signature] Date 30 DEC 1998

Surveyor's Michigan License No. 29251

NOTE: All bearings are compass bearings corrected for declination (6°W). All distances are to a nail and tag in the side of witness object unless otherwise noted.