

SURVEY & REMONUMENTATION

DEC 18 1999

LAND CORNER RECORDATION CERTIFICATE
 Filing Requirement of Act 74, Mich. P.A. 1970
 Chippewa County Remonumentation Corner

For corners in **SECTION**

<u>Chippewa</u>	Located In:	Corner Code #
1. Public Land Survey	T <u>46N</u> R <u>2E</u>	<u>E-3</u>
	T ___ R ___	___
	T ___ R ___	___
	T ___ R ___	___
2. Property Controlling in Section	S ___ T ___ R ___	
	S ___ T ___ R ___	
3. Miscellaneous Property in Sec.	S ___ T ___ R ___	
	S ___ T ___ R ___	

\$7.00 LAND CORNER
 \$2.00 MSSR
 21 JAN 1999 10:11:34 AM Receipt #13123
 RECEIVED FOR RECORD
 CHIPPEWA COUNTY - STATE OF MICHIGAN
 SHARON H. KENNEDY, REGISTER OF DEEDS

BOOK **10** PAGE **331**
 Register of Deeds Stamp & File Number

4. Lot No. _____, Recorded Plat _____
 5. Private Claims _____

I, Larry R. Rogers in a field survey on October 15, 1998, do hereby state that under requirements of P.A. 74, Michigan P.A. of 1970, the corner points mentioned in lines 1 and 2 above were in conformance with regulations and rules therefore as required in the current manual of survey instructions of the United States Department of the Interior, Bureau of Land Management or by a decree of a Court of Law and/or that the corner points mentioned in lines 3, 4 and 5 above were in conformance with the rules of the Michigan Board of Land Surveyors or by a Decree of a Court of Law; established, re-established, monumented, recovered, found as expressed below:

NOTE: Not more than 2 corners, all in the same town and range, may be recorded on this certificate.

A	B	C	D	E	F	G	H	I	J	K	L	M
1												
2	6		5		4		3		2		1	
3				●								
4	7		8		9		10		11		12	
5												
6	18		17		16		15		14		13	
7												
8	19		20		21		22		23		24	
9												
10	30		29		28		27		26		25	
11												
12	31		32		33		34		35		36	
13												

A. Description of original monument and accessories and/or subsequent restoration:

(E-3) Northeast Corner, Section 8, Township 46 North, Range 2 East.

The original corner was placed in 1845 by James H. Mullett. In 1919 County Surveyor Brown could not find corner so measured East from South 1/4 corner of Section 5 and reset corner in "open marsh". Brown's distance to Northeast corner of Section 5 was 5295 feet. In 1975, a B.L.M. dependent resurvey found and accepted a 3/4" iron bar 6" below the North shoulder of an East - West gravel road. B.L.M. distance to Northeast corner of Section 5 was 5280.66 feet. In 1987, William L. Karr, P.S. 27450 found a 1 1/4" iron on the North edge of Seven Mile Road. Distance to Northeast Corner, Section 5 is 5280.74 and distance to South 1/4 Corner Section 5 is 2636.36 feet (B.L.M. 2636.04 feet). Karr filed a L.C.R.C. in Liber 8, Page 264 of the Chippewa County Corner Records.

B. Description of corner evidence found and/or method applied in restoring or reestablishing corner:

(E-3) Northeast Corner, Section 8, Township 46 North, Range 2 East.

This corner is being perpetuated as part of the Chippewa County Remonumentation Program. Found 1 1/4" iron pin on North shoulder of 7 Mile Road and recovered two Karr witnesses. Accepted corner position as found.



C. Description of monument for corner and accessories established to perpetuate locating the position of the corner:

(E-3) Northeast Corner, Section 8, Township 46 North, Range 2 East.

Corner is a 1 1/4" iron pin (with mushroomed top) 2" below grade on the North shoulder of 7 Mile Road.

Witnesses:

16" Maple	N40°W	34.60 feet
10" White Birch	S16°W	30.08 feet
5" White Birch	S38°E	41.40 feet
12" Ash	N08°E	35.71 feet
Steel Fence Post	North	2.0 feet

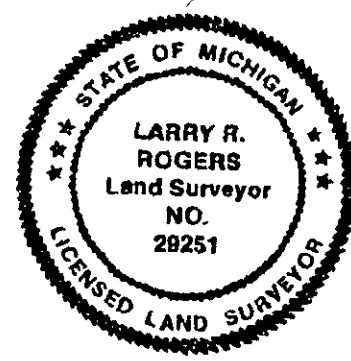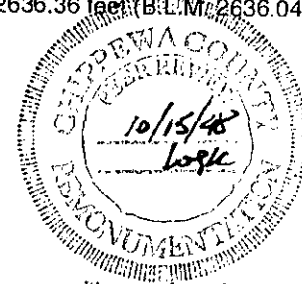

Signed by [Signature]
 License No. 29251

Date 30 DEC 1998

NOTE: All bearings are compass bearings corrected for declination (6°W). All distances are to a nail and tag in the side of witness object unless otherwise noted.