

MAR 18 1999

**LAND CORNER RECORDATION CERTIFICATE**  
Filing Requirement of Act 74, Mich. P.A. 1970  
Chippewa County Remonumentation Corner

For corners in SECTION


<u>Chippewa</u>	Located In:	Corner Code #
1. Public Land Survey	T <u>46N</u> R <u>2E</u>	<u>E-4</u>
	T _____ R _____	_____
	T _____ R _____	_____
	T _____ R _____	_____
2. Property Controlling in Section	S _____ T _____ R _____	
	S _____ T _____ R _____	
3. Miscellaneous Property in Sec.	S _____ T _____ R _____	
	S _____ T _____ R _____	
4. Lot No. _____, Recorded Plat _____		
5. Private Claims _____		

\$7.00 LAND CORNER  
\$2.00 HSSR  
21 JAN 1999 10:14:22 AM Receipt #13103  
RECEIVED FOR RECORD  
CHIPPewa COUNTY - STATE OF MICHIGAN  
SHARON H. KENNEDY, REGISTER OF DEEDS

BOOK 10 PAGE 335  
Register of Deeds Stamp & File Number

I, Larry R. Rogers in a field survey on October 15, 1998, do hereby state that under requirements of P.A. 74, Michigan P.A. of 1970, the corner points mentioned in lines 1 and 2 above were in conformance with regulations and rules therefore as required in the current manual of survey instructions of the United States Department of the Interior, Bureau of Land Management or by a decree of a Court of Law and/or that the corner points mentioned in lines 3, 4 and 5 above were in conformance with the rules of the Michigan Board of Land Surveyors or by a Decree of a Court of Law; established, re-established, monumented, recovered, found as expressed below:

**NOTE: Not more than 2 corners, all in the same town and range, may be recorded on this certificate.**

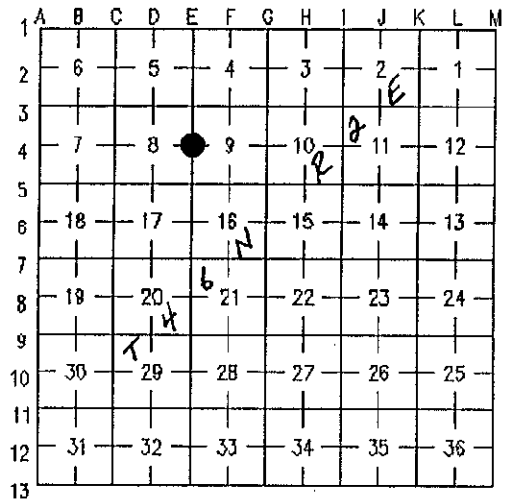


A. Description of original monument and accessories and/or subsequent restoration:  
(E-4) 1/4 Corner Common to Sections 8 and 9, Township 46 North, Range 2 East.  
The original corner was placed in 1845 by James H. Mullett. 1919 County Surveyor notes recite distance of 2640 feet from Northwest corner of Section 9 to West 1/4 corner but do not describe corner. A 1975 B.L.M. dependent resurvey measures this line between Sections 8 and 9 (5291.88 feet) but does not set the 1/4 corner. In 1996, Ron Bischer, P.S. 22428 re-established this 1/4 corner by single proportionate measurement between Northeast and Southeast corners of Section 8.

B. Description of corner evidence found and/or method applied in restoring or reestablishing corner:  
(E-4) 1/4 Corner Common to Sections 8 and 9, Township 46 North, Range 2 East.  
This corner is being perpetuated as part of the Chippewa County Remonumentation Program. Found a 1/2" iron pin with P.S. cap 22428 as set by Bischer. This corner position is harmoniously related to existing local monumentation and is accepted as the best existing evidence of the position of the original corner.

C. Description of monument for corner and accessories established to perpetuate locating the position of the corner:  
(E-4) 1/4 Corner Common to Sections 8 and 9, Township 46 North, Range 2 East.  
Corner is a 1/2" iron pin with P.S. cap 22428.

Witnesses:		
8" Cedar	N25°E	21.43 feet
18" Hemlock	S88°W	20.20 feet
10" Maple	S07°W	24.08 feet
12" Cedar	S54°E	15.29 feet
Steel Fence Post	North	2.0 feet



Signed by  Date 30 DEC 1998

Surveyor's Michigan License No. 29251

NOTE: All bearings are compass bearings corrected for declination (6°W). All distances are to a nail and tag in the side of witness object unless otherwise noted.