

CURRENT RECORD

JAN 19 1999

SECTION

LAND CORNER RECORDATION CERTIFICATE
Filing Requirement of Act 74, Mich. P.A. 1970
Chippewa County Remonumentation Corner

For corners in

Chippewa County Located In: Corner Code #
1. Public Land Survey T 46N R 2E E-7
2. Property Controlling in Section S T R
3. Miscellaneous Property in Sec. S T R
4. Lot No. Recorded Plat
5. Private Claims

\$7.00 LAND CORNER
\$2.00 MSSR
21 JAN 1999 10:09:12 AM Receipt #13123
RECEIVED FOR RECORD
CHIPPEWA COUNTY - STATE OF MICHIGAN
SHARON H. KENNEDY, REGISTER OF DEEDS
BOOK 10 PAGE 328
Register of Deeds Stamp & File Number

I, Larry R. Rogers in a field survey on November 06, 1998, do hereby state that under requirements of P.A. 74, Michigan P.A. of 1970, the corner points mentioned in lines 1 and 2 above were in conformance with regulations and rules therefore as required in the current manual of survey instructions of the United States Department of the Interior, Bureau of Land Management or by a decree of a Court of Law and/or that the corner points mentioned in lines 3, 4 and 5 above were in conformance with the rules of the Michigan Board of Land Surveyors or by a Decree of a Court of Law; established, re-established, monumented, recovered, found as expressed below:

NOTE: Not more than 2 corners, all in the same town and range, may be recorded on this certificate.


Grid table with columns A-M and rows 1-13. Contains handwritten numbers and letters (E, R, N, W, K) indicating corner locations.

A. Description of original monument and accessories and/or subsequent restoration:
(E-7) Northeast Corner of Section 20, Township 46 North, Range 2 East.
The original corner was placed in 1845 by James H. Mullett. 1935 County Surveyor records call for an iron pipe with several witnesses. In 1982, William L. Karr, P.S. 27450 recovered a 1" iron pipe and three County Surveyor witnesses and filed a C.C.B.C. in Liber 6, Page 359 of the Chippewa County Corner Records.

B. Description of corner evidence found and/or method applied in restoring or reestablishing corner:
(E-7) Northeast Corner of Section 20, Township 46 North, Range 2 East.
This corner is being perpetuated as part of the Chippewa County Remonumentation Program. Found a 1" iron pipe, two witnesses from County Surveyor notes and three witnesses from Karr survey. Corner falls in mowed yard between two cabins. Accepted corner position as found.

C. Description of monument for corner and accessories established to perpetuate locating the position of the corner:
(E-7) Northeast Corner of Section 20, Township 46 North, Range 2 East.
Corner is a 1" iron pipe flush with ground in mowed yard.

- Witnesses:
SE Corner White Cabin N51°E 44.88 feet
18" Red Pine N21°E 28.82 feet
18" Red Maple N65°W 31.14 feet
12" Red Maple S01°W 15.32 feet
16" Spruce N64°E 65.61 feet
Iron Pipe West 292.3 feet

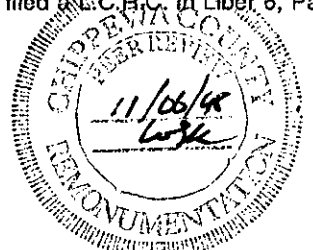

Signed by: [Signature]

Date 28 DEC 1998

Surveyor's Michigan License No. 29251

NOTE: All bearings are compass bearings corrected for declination (6°W). All distances are to a nail and tag in the side of witness object unless otherwise noted.