

1257-1198

LAND CORNER RECORDATION CERTIFICATE

Filing Requirement of Act 74, Mich. P.A. 1970

Chippewa County Remonumentation Corner

For corners in SECTION

Chippewa Located In: Corner Code #

1. Public Land Survey T 46N R 2E F-3
 T ___ R ___
 T ___ R ___
 T ___ R ___

2. Property Controlling S ___ T ___ R ___
 in Section S ___ T ___ R ___

3. Miscellaneous S ___ T ___ R ___
 Property in Sec. S ___ T ___ R ___


\$7.00 LAND CORNER
 \$2.00 MSSR
 21 JAN 1999 10:12:20 AM Receipt #13123
 RECEIVED FOR RECORD
 CHIPPEWA COUNTY - STATE OF MICHIGAN
 SHARON H. KENNEDY, REGISTER OF DEEDS

BOOK **10** PAGE **332**
 Register of Deeds Stamp & File Number

4. Lot No. _____, Recorded Plat _____
 5. Private Claims _____

I, Larry R. Rogers in a field survey on October 15, 1998, do hereby state that under requirements of P.A. 74, Michigan P.A. of 1970, the corner points mentioned in lines 1 and 2 above were in conformance with regulations and rules therefore as required in the current manual of survey instructions of the United States Department of the Interior, Bureau of Land Management or by a decree of a Court of Law and/or that the corner points mentioned in lines 3, 4 and 5 above were in conformance with the rules of the Michigan Board of Land Surveyors or by a Decree of a Court of Law; established, re-established, monumented, recovered, found as expressed below:

NOTE: Not more than 2 corners, all in the same town and range, may be recorded on this certificate.

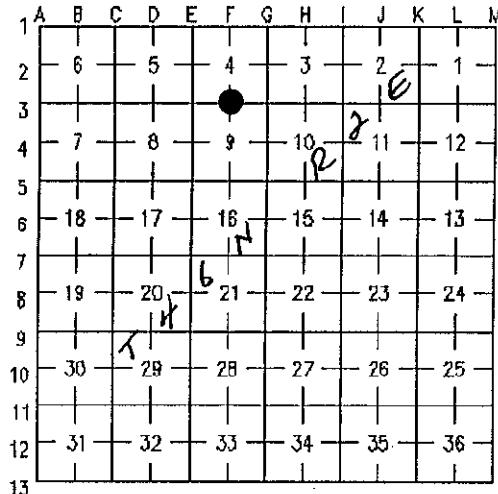

A. Description of original monument and accessories and/or subsequent restoration:
 (F-3) 1/4 Corner Common to Section 4 and 9, Township 46 North, Range 2 East.

The original corner was placed in 1845 by James H. Mullett. County Surveyor notes make no specific reference to this corner. Corner was re-established in 1996 by Ronald Bischer, P.S. 22428 apparently on the extension of the centerline of 7 Mile Road at record distance East from the Southwest corner of Section 4.



B. Description of corner evidence found and/or method applied in restoring or reestablishing corner:
 (F-3) 1/4 Corner Common to Section 4 and 9, Township 46 North, Range 2 East.

This corner is being perpetuated as part of the Chippewa County Remonumentation Program. Found a 1/2" iron pin with P.S. cap 22428 on the extension of the centerline of Seven Mile Road, and the approximate extension of the East edge of the County Road to South and 2638.54 feet East of the Southwest corner of Section 4. This corner position is harmoniously related to existing local control and is accepted on the best existing evidence of the position of the original corner.

C. Description of monument for corner and accessories established to perpetuate locating the position of the corner:
 (F-3) 1/4 Corner Common to Section 4 and 9, Township 46 North, Range 2 East.

Corner is a 1/2" iron pin with P.S. cap 22428 on the extension of the centerline of Seven Mile Road and on the approximate extension of the East edge of County Road to South.

Witnesses:

12" Birch	S52°W	85.74 feet
12" Tamarack	N16°W	170.50 feet
3/4" x 24" witness pipe	N73°W	60.48 feet
3/4" x 24" witness pipe	S27°E	31.05 feet
6" Cherry	North	27.48 feet
4" Aspen	S31°E	46.28 feet



Signed by _____ Date 30 DEC 1998

Surveyor's Michigan License No. 29251

NOTE: All bearings are compass bearings corrected for declination (6°W). All distances are to a nail and tag in the side of witness object unless otherwise noted.