

RECORDED

MAR 1 1999

SECTION


LAND CORNER RECORDATION CERTIFICATE
Filing Requirement of Act 74, Mich. P.A. 1970
Chippewa County Remonumentation Corner

For corners in

Chippewa County Located In: Corner Code #
1. Public Land Survey T 46N R 2E F-7
2. Property Controlling in Section S T R
3. Miscellaneous Property in Sec. S T R
4. Lot No. Recorded Plat
5. Private Claims

\$7.00 LAND CORNER
\$2.00 HSSR
21 JAN 1999 10:09:48 AM Receipt #13123
RECEIVED FOR RECORD
CHIPPEWA COUNTY - STATE OF MICHIGAN
SHARON H. KENNEDY, REGISTER OF DEEDS
BOOK 10 PAGE 329
Register of Deeds Stamp & File Number

I, Larry R. Rogers in a field survey on November 25, 1998, do hereby state that under requirements of P.A. 74, Michigan P.A. of 1970, the corner points mentioned in lines 1 and 2 above were in conformance with regulations and rules therefore as required in the current manual of survey instructions of the United States Department of the Interior, Bureau of Land Management or by a decree of a Court of Law and/or that the corner points mentioned in lines 3, 4 and 5 above were in conformance with the rules of the Michigan Board of Land Surveyors or by a Decree of a Court of Law; established, re-established, monumented, recovered, found as expressed below:

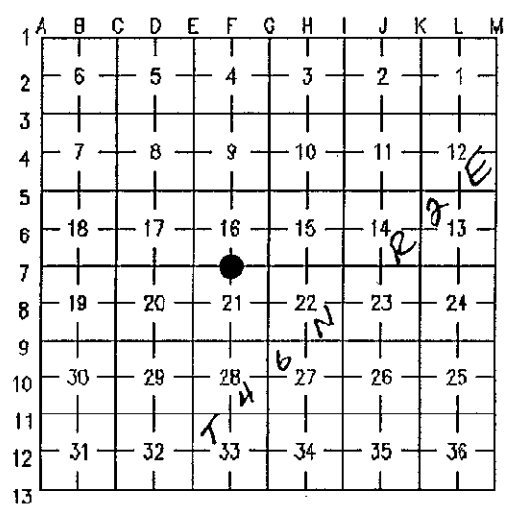

NOTE: Not more than 2 corners, all in the same town and range, may be recorded on this certificate.


A. Description of original monument and accessories and/or subsequent restoration:
(F-7) 1/4 Corner Common to Sections 16 and 21, Township 46 North, Range 2 East.
The original corner was placed in 1845 by James H. Mullett. 1935 County Surveyor notes show corner to be a concrete monument 2640 feet East of the Southwest corner of Section 16. IN 1982, William L. Karr, P.S. 27450 found a concrete monument with a 4" brass tablet stamped "Chippewa County Corner" and also found two witnesses from County Surveyor notes. Karr filed a L.C.R.C. in Liber 6, Page 359 of the Chippewa County Records.



B. Description of corner evidence found and/or method applied in restoring or reestablishing corner:
(F-7) 1/4 Corner Common to Sections 16 and 21, Township 46 North, Range 2 East.
This corner is being perpetuated as part of the Chippewa County Remonumentation Program. Found a 4" diameter concrete monument with stamped brass tablet as set by County Surveyor and recorded by Karr. Also recovered four Karr witnesses. Accepted Corner position as found. Distance to Southwest Corner of Section 16 is 2639.84 feet.

C. Description of monument for corner and accessories established to perpetuate locating the position of the corner:
(F-7) 1/4 Corner Common to Sections 16 and 21, Township 46 North, Range 2 East.
Corner is a 4" diameter concrete monument with brass tablet stamped "Chippewa County Corner" approximately 71 feet South of centerline of East - West trail and at intersection of brush lines North, South, East and West.

Witnesses:
5" Spruce N24°E 26.31 feet
10" Aspen N52°W 18.30 feet
8" Hemlock S54°W 6.40 feet
8" Spruce N86°E 20.84 feet
Steel Fence Post North 2.0 feet

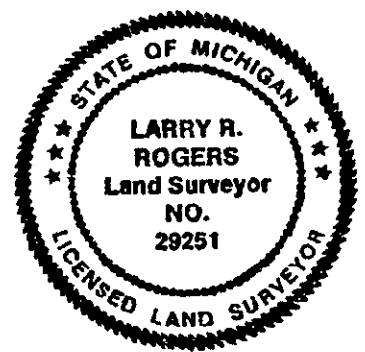

Signed by [Signature] Date 30 DEC 1998

Surveyor's Michigan License No. 29251

NOTE: All bearings are compass bearings corrected for declination (6°W). All distances are to a nail and tag in the side of witness object unless otherwise noted.