

RECORDED

1998

LAND CORNER RECORDATION CERTIFICATE

Filing Requirement of Act 74, Mich. P.A. 1970

Chippewa County Remonumentation Corner

For corners in

SECTION

Chippewa County

Located In:

Corner Code #

1. Public Land Survey

T 46N R 2E

G-5

T R

T R

T R

2. Property Controlling in Section

S T R

S T R

3. Miscellaneous Property in Sec.

S T R

S T R

4. Lot No. , Recorded Plat

5. Private Claims

\$7.00 LAND CORNER

\$2.00 MSSR

21 JAN 1999 10:05:00 AM Receipt #13103

RECEIVED FOR RECORD

CHIPPEWA COUNTY - STATE OF MICHIGAN SHARON H. KENNEDY, REGISTER OF DEEDS

BOOK 10 PAGE 323

Register of Deeds Stamp & File Number

I, Larry R. Rogers in a field survey on October 15, 1998, do hereby state that under requirements of P.A. 74, Michigan P.A. of 1970, the corner points mentioned in lines 1 and 2 above were in conformance with regulations and rules therefore as required in the current manual of survey instructions of the United States Department of the Interior, Bureau of Land Management or by a decree of a Court of Law and/or that the corner points mentioned in lines 3, 4 and 5 above were in conformance with the rules of the Michigan Board of Land Surveyors or by a Decree of a Court of Law; established, re-established, monumented, recovered, found as expressed below:


NOTE: Not more than 2 corners, all in the same town and range, may be recorded on this certificate.


A. Description of original monument and accessories and/or subsequent restoration:

(G-5) Northeast Corner, Section 16, Township 46 North, Range 2 East.

The original corner was placed in 1845 by James H. Mullett. County Surveyor records make no specific reference to this Corner. In 1982, William L. Karr, P.S. 27450 found no evidence of original corner position and "used local evidence to re-establish corner position." Karr filed a L.C.R.C. in Liber 6, Page 358 of the Chippewa County Corner Records. Corner has since been used by several other surveyors.

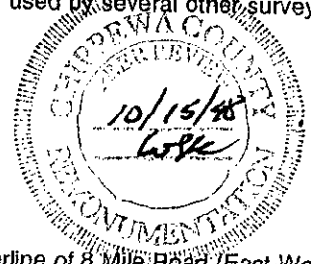

B. Description of corner evidence found and/or method applied in restoring or reestablishing corner:

(G-5) Northeast Corner, Section 16, Township 46 North, Range 2 East

This corner is being perpetuated as part of the Chippewa County Remonumentation Program.

Found no evidence of original corner position. Found Karr 1" drill rod 12" below grade and in centerline of 8 Mile Road (East-West, gravel).

Recovered three Karr witnesses that match well. Accepted corner position as found.

C. Description of monument for corner and accessories established to perpetuate locating the position of the corner:

(G-5) Northeast Corner, Section 16, Township 46 North, Range 2 East

Corner is a 1" x 36" drill rod 12" below grade in centerline of 8 Mile Road.

Witnesses:

Table with 3 columns: Witness, Bearing, Distance. Includes 7" Twin Ash, 10" Willow, 10" White Birch, 8" Maple, 8" Ash, 1/2" capped iron pin.

Signed by: [Signature]

Date 20 Dec 1998

Surveyor's Michigan License No. 29251

NOTE: All bearings are compass bearings corrected for declination (6°W). All distances are to a nail and tag in the side of witness object unless otherwise noted.



FORM APPROVED BY MICHIGAN STATE BOARD OF PROFESSIONAL SURVEYORS, JAN. 28, 1971 REVISED MAY 14, 1975 REVISED JAN., 1983 REVISED OCT., 1995