

SECTION

LAND CORNER RECORDATION CERTIFICATE
Filing Requirement of Act 74, Mich. P.A. 1970
Chippewa County Remonumentation Corner

For corners in

Chippewa County Located In: Corner Code #
1. Public Land Survey T 46N R 2E G-7
2. Property Controlling in Section S T R
3. Miscellaneous Property in Sec. S T R

\$7.00 LAND CORNER
\$2.00 MSSR
21 JAN 1999 10:10:49 AM Receipt #131
RECEIVED FOR RECORD
CHIPPEWA COUNTY - STATE OF MICHIGAN
SHARON H. KENNEDY, REGISTER OF DEEDS
BOOK 10 PAGE 330
Register of Deeds Stamp & File Number


4. Lot No. Recorded Plat
5. Private Claims

I, Larry R. Rogers in a field survey on November 06, 1998, do hereby state that under requirements of P.A. 74, Michigan P.A. of 1970, the corner points mentioned in lines 1 and 2 above were in conformance with regulations and rules therefore as required in the current manual of survey instructions of the United States Department of the Interior, Bureau of Land Management or by a decree of a Court of Law and/or that the corner points mentioned in lines 3, 4 and 5 above were in conformance with the rules of the Michigan Board of Land Surveyors or by a Decree of a Court of Law; established, re-established, monumented, recovered, found as expressed below:

NOTE: Not more than 2 corners, all in the same town and range, may be recorded on this certificate.


A. Description of original monument and accessories and/or subsequent restoration:
(G-7) Northeast Corner of Section 21, Township 46 North, Range 2 East.
The original corner was placed in 1845 by James H. Mullett. County Surveyor records make no specific reference to Corner. In 1982, William L. Karr, P.S. 27450 found no evidence of original and "re-established corner position from NE & SW Corners of Section 16 using old County Surveyor notes". Karr filed a L.C.R.C. in Liber 6, Page 358 of the Chippewa County Corner Records.

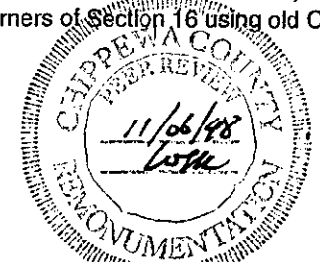

B. Description of corner evidence found and/or method applied in restoring or reestablishing corner:
(G-7) Northeast Corner of Section 21, Township 46 North, Range 2 East.
This corner is being perpetuated as part of the Chippewa County Remonumentation Program. Found 1" drill rod set by Karr and recovered two witnesses. Corner falls 6 feet Southwesterly of the Southwesterly edge of Homestead Road (asphalt) and on the extension of the centerline of a 2-track road to West. Brush lines to North and South. Accepted corner position as found.

C. Description of monument for corner and accessories established to perpetuate locating the position of the corner:
(G-7) Northeast Corner of Section 21, Township 46 North, Range 2 East.
Corner is a 1" drill rod 6 feet Southwesterly of edge of asphalt of Homestead Road.

Witnesses:
Utility Pole (SUI/115) N20'E 56.11 feet
8" White Pine N74'W 75.33 feet
10" Jack Pine S79'W 42.24 feet
12" Jack Pine N54'E 75.31 feet
Centerline of Homestead Road N47'E 17.6 feet



Signed by: [Signature]

Date 28 DEC 1998

Surveyor's Michigan License No. 29251

NOTE: All bearings are compass bearings corrected for declination (6'W). All distances are to a nail and tag in the side of witness object unless otherwise noted.