

REMONUMENTATION

LAND CORNER RECORDATION CERTIFICATE
Filing Requirement of Act 74, Mich. P.A. 1970
Chippewa County Remonumentation Corner

For corners in

Chippewa

SECTION

Located In:

Corner Code #

- | | | | | | |
|------------------------------------|--------|-------|------|--------|----|
| 1. Public Land Survey | SAME | T 46N | R 2E | A/B-1 | ✓ |
| | CORNER | T 47N | R 2E | A/B-13 | |
| | | T | R | | |
| | | T | R | | |
| 2. Property Controlling in Section | S | T | R | | #9 |
| | S | T | R | | |
| 3. Miscellaneous Property in Sec. | S | T | R | | |
| | S | T | R | | |

\$7.00 LAND CORNER
 \$2.00 MSSR
 21 JAN 1999 10:34:05 AM Receipt #13123
 RECEIVED FOR RECORD
 CHIPPEWA COUNTY - STATE OF MICHIGAN
 SHARON H. KENNEDY, REGISTER OF DEEDS

BOOK 10 PAGE 359

Register of Deeds Stamp & File Number


4. Lot No. _____, Recorded Plat _____
 5. Private Claims _____

I, Larry R. Rogers in a field survey on November 5, 1998, do hereby state that under requirements of P.A. 74, Michigan P.A. of 1970, the corner points mentioned in lines 1 and 2 above were in conformance with regulations and rules therefore as required in the current manual of survey instructions of the United States Department of the Interior, Bureau of Land Management or by a decree of a Court of Law and/or that the corner points mentioned in lines 3, 4 and 5 above were in conformance with the rules of the Michigan Board of Land Surveyors or by a Decree of a Court of Law; established, re-established, monumented, recovered, found as expressed below:

NOTE: Not more than 2 corners, all in the same town and range, may be recorded on this certificate.

	A	B	C	D	E	F	G	H	I	J	K	L	M
1													
2		6		5		4		3		2		1	
3													
4		7		8		9		10		11		12	
5													
6		18		17		16		15		14		13	
7													
8		19		20		21		22		23		24	
9													
10		30		29		28		27		26		25	
11													
12		31		32		33		34		35		36	
13													

A. Description of original monument and accessories and/or subsequent restoration:
(A/B-1) Meander Corner on North line of Section 6, Township 46 North, Range 2 East.
 Original corner post was placed in October 1845 by John Mullett. Corner shown in 1933 subdivision of "Plat of Hiawatha Grounds" as a 1" iron in concrete. Corner was referred to in 1975 survey by N.D. Alix as a found iron pipe (Job #: 74040-S). In 1991, Larry Weinreis, P.S. 32343, found a concrete monument with 1/2" iron pin and filed a L.C.R.C. in Liber 7, Page 321 of the Chippewa County corner records. Weinreis corner has been used in several surveys since 1991.

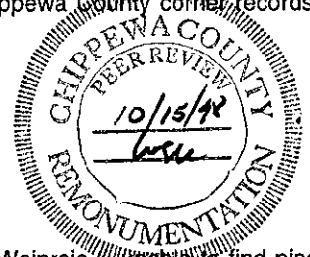


B. Description of corner evidence found and/or method applied in restoring or reestablishing corner:
(A/B-1) Meander Corner on North line of Section 6, Township 46 North, Range 2 East.
 This corner is being perpetuated as part of the Chippewa County Remonumentation Program. Found no evidence of original corner position. Found 1/2" iron pin in concrete monument as recorded by Weinreis. Accepted corner position as found and witnessed. Corner is 8 feet North of centerline of East - West two track road. Distance East to 1/4 Corner is 1444.80 (1462.56 G.L.O.)

C. Description of monument for corner and accessories established to perpetuate locating the position of the corner:
A/B - 1 Witness Corner to Meander Corner on North line of Section 6, Township 46 North, Range 2 East.
 Corner is a concrete monument with 1/2" iron pin, 28 feet East of water's edge of the St. Mary's River. Concrete around top of monument has been destroyed.

- Witnesses:
- | | | |
|-------------------|-------|------------|
| Concrete Monument | North | 32.90 feet |
| 10" Ash | N53°E | 47.85 feet |
| 5" Ash | S62°E | 48.19 feet |
| 14" Ash | S03°E | 48.68 feet |

Signed by Date 30 Dec 1998

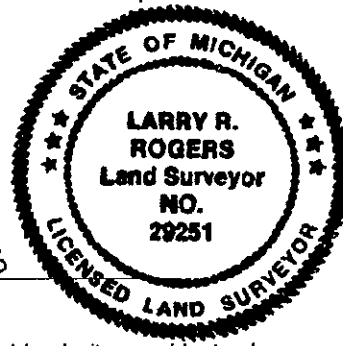

Surveyor's Michigan License No. 29251
 NOTE: All bearings are compass bearings corrected for declination (6°W). All distances are to a nail and tag in the side of witness object unless otherwise noted.

FORM APPROVED BY MICHIGAN STATE BOARD OF PROFESSIONAL SURVEYORS, JAN. 23, 1971
 REVISED MAY 14, 1975
 REVISED JAN., 1983
 REVISED OCT., 1995