

CHIPPEWA COUNTY REMONUMENTATION CORNER

LAND CORNER RECORDATION CERTIFICATE

Filing Requirement of Act 74, Mich. P.A. 1970

For corners in Chippewa

(County)

Located In:

Corner Code #

- 1. Public Land Survey T 46N R 3W J-5
2. Property Controlling in Section S T R
3. Miscellaneous Property in Sec. S T R

\$ 7.00 LAND CORNER
\$ 2.00 MSSR
24 OCT 94 2:24 P.M. RECEIPT# 811
RECEIVED FOR RECORD
CHIPPEWA COUNTY - STATE OF MICHIGAN
SHARON H. KENNEDY, REGISTER OF DEEDS

Register of Deeds Stamp & File Number

- 4. Lot No. , Recorded Plat
5. Private Claims

I, Larry R. Rogers, in a field survey on September 1, 19 93, do hereby certify that under requirements of P.A. 74, Michigan P.A. of 1970, the corner points mentioned in lines 1 and 2 above were in conformance with regulations and rules therefore as required in the current manual of survey instructions of the United States Department of the Interior, Bureau of Land Management or by a decree of a Court of Law and/or that the corner points mentioned in lines 3, 4 and 5 above were in conformance with the rules of the Michigan Board of Land Surveyors or by a Decree of a Court of Law; established, re-established, monumented, re-monumented, recovered, found as expressed below:

NOTE: Not more than 4 corners, all in the same town and range, may be recorded on this certificate.

A. Description of original monument and accessories and/or subsequent restoration: (J-5) 1/4 Corner common to Sections 11 & 14, T46N-R3W

1849 Harvey Mellen, set Cedar post.
10" Yellow Birch N10°E 22 links
16" Hemlock S34°W 23 links

B. Description of corner evidence found and/or method applied in restoring or reestablishing corner: Found no evidence of corner position. Re-established corner position by Single Proportionate Measurement.

C. Description of monument for corner and accessories established to perpetuate locating the position of the corner: Corner is a 3/4" x 24" iron with a 3" diameter aluminum "Chippewa County Remonumentation" cap. Corner falls 150' North of the centerline of old railroad grade.

Witnesses:

- 12" Cedar N70°E 29.04'
12" Black Spruce S18°E 45.82'
8" Yellow Birch S34°W 23.50'
14" Spruce N43°W 23.62'


Signed by [Signature]

Date 10 OCT 1994

1687-00

Surveyor's Michigan License No. 29251

NOTE: Bearings are compass bearings corrected for declination. Distances are to a nail in side of witness objects unless noted.

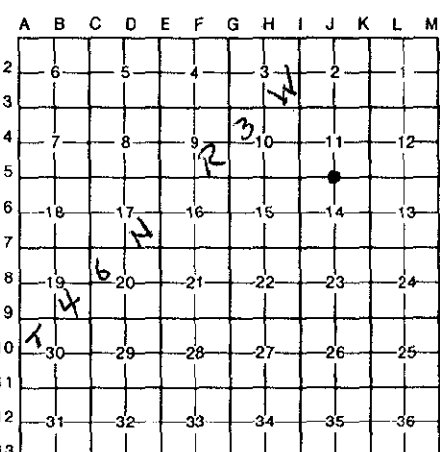

SURVEY & REMONUMENTATION

NOV 07 1994

COMMISSION

