

CHIPPEWA COUNTY REMONUMENTATION CORNER

LAND CORNER RECORDATION CERTIFICATE  
Filing Requirement of Act 74, Mich. P.A. 1970

For corners in  
Chippewa

(County)

Located In:

Corner Code ##

1. Public Land Survey	T <u>46N</u> R <u>3W</u>	<u>L-5</u>
	T _____ R _____	_____
	T _____ R _____	_____
	T _____ R _____	_____
2. Property Controlling in Section	S _____ T _____ R _____	_____
	S _____ T _____ R _____	_____
3. Miscellaneous Property in Sec.	S _____ T _____ R _____	_____
	S _____ T _____ R _____	_____

\$ 7.00 LAND CORNER  
 \$ 2.00 MSSR  
 24 OCT 94 2:25 P.M. RECEIPT# 811  
 RECEIVED FOR RECORD  
 CHIPPEWA COUNTY - STATE OF MICHIGAN  
 SHARON H. KENNEDY, REGISTER OF DEEDS

Register of Deeds Stamp & File Number


- 4. Lot No. \_\_\_\_\_, Recorded Plat \_\_\_\_\_
- 5. Private Claims \_\_\_\_\_

I, Larry R. Rogers, in a field survey on May 14, 19 93, do hereby certify that under requirements of P.A. 74, Michigan P.A. of 1970, the corner points mentioned in lines 1 and 2 above were in conformance with regulations and rules therefore as required in the current manual of survey instructions of the United States Department of the Interior, Bureau of Land Management or by a decree of a Court of Law and/or that the corner points mentioned in lines 3, 4 and 5 above were in conformance with the rules of the Michigan Board of Land Surveyors or by a Decree of a Court of Law; established, re-established, monumented, re-monumented, recovered, found as expressed below:

NOTE: Not more than 4 corners, all in the same town and range, may be recorded on this certificate.

A. Description of original monument and accessories and/or subsequent restoration:  
(L-5) 1/2 Corner Common to Sections 12 & 13, T46N-R3W

1849 Harvey Mellen, set Cedar post.  
 14" Hemlock N43°E 28 links  
 12" Yellow Birch S85°E 22 links

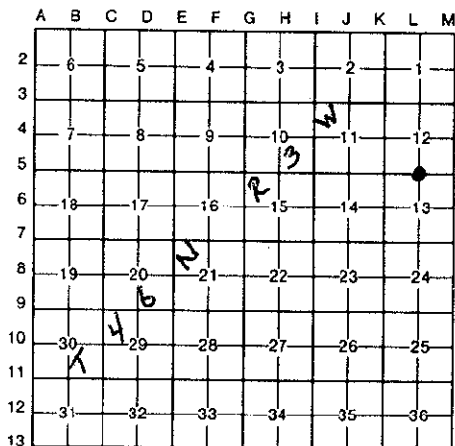

B. Description of corner evidence found and/or method applied in restoring or reestablishing corner:  
 This corner is being perpetuated as part of the Chippewa County Remonumentation Program.

Found no evidence of corner position. Re-established position using the intersection of split of right-of-way fences to the East and the remains of North-South fence line. Corner falls in old road bed.

SURVEY & REMONUMENTATION


NOV 07 1994

COMMISSION

C. Description of monument for corner and accessories established to perpetuate locating the position of the corner:  
 Corner is a 1/2" x 48" iron with L.S. cap #29251. Corner was set 6" below ground and falls 4' north of the centerline of old East-West road bed.

Witnesses:

12" White Birch	N02°E	40.68'
6" Spruce	N52°E	10.39'
6" Spruce	N78°E	58.68'
6" Spruce	S24°W	65.40'
6" Spruce	S78°W	85.77'

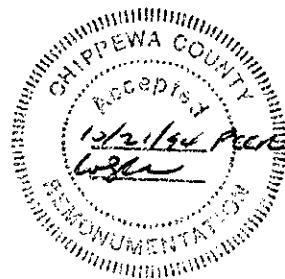

Signed by [Signature] Date 10 OCT 1994 1687-00  
 Surveyor's Michigan License No. 29251

NOTE: Bearings are compass bearings corrected for declination.  
 Distances are to a nail in side of witness objects unless noted.