

CHIPPEWA COUNTY REMONUMENTATION CORNER

LAND CORNER RECORDATION CERTIFICATE
Filing Requirement of Act 74, Mich. P.A. 1970

For corners in

Chippewa
(County)

Located In: _____ Corner Code # _____

1. Public Land Survey
 T46N R 2W
 T46N R 3W
 T _____ R _____
 T _____ R _____

2. Property Controlling
 In Section S _____ T _____ R _____
 S _____ T _____ R _____

3. Miscellaneous
 Property in Sec. S _____ T _____ R _____

4. Lot No. _____ Recorded Plat _____

5. Private Claims _____

*A-7) Same
M-7) Corner*

MAR 27 1996

COMMISSION

\$ 7.00 LAND CORNER
 \$ 2.00 HSSR
 29 FEB 96 9:28 A.M. RECEIPT# 462
 RECEIVED FOR RECORD
 CHIPPEWA COUNTY - STATE OF MICHIGAN
 SHARON H. KENNEDY, REGISTER OF DEEDS

Register of Deeds Stamp & File Number

	A	B	C	D	E	F	G	H	I	J	K	L	M
1													
2		6	5	4	3	2	1						
3													
4		7	8	9	10	11	12						
5													
6		18	17	16	15	14	13						
7													
8		19	20	21	22	23	24						
9													
10		30	29	28	27	26	25						
11													
12		31	32	33	34	35	36						
13													


I, William L. Karr, in a field survey on Dec. 13, 1995 do hereby state that under requirements of P.A. 74, Michigan P.A. of 1970, the corner points mentioned in lines 1 and 2 above were in conformance with regulations and rules therefore as required in the current manual of survey instructions of the United States Department of the Interior, Bureau of Land Management or by a decree of a Court of Law and/or that the corner points mentioned in lines 3, 4 and 5 above were in conformance with the rules of the Michigan Board of Land Surveyors or by a Decree of a Court of Law; established, re-established, monumented, recovered, found as expressed below:

NOTE: Not more than 2 corners, all in the same town and range, may be recorded on this certificate.

- A. Description of original monument and accessories and/or subsequent restoration:
 (A-7) Section Corner 18 & 19, T46N, R2W and Sections 13 & 24, T46N, R3W (M-7)
 1840: Austin Burt set post
 Fir 11" S73°W No distance given Fir 9" N63°W "do"
 1941: Corner was established as part of a G.L.O. dependent resurvey. Set 6" diameter concrete monument with brass cap.
 1977: J.H. Granger, P.S. 16041 found a concrete monument with G.L.O. brass cap. Corner was recorded in Liber 1, Page 251.
 1987: N. Hill, P.S. 27447 (MDOT) found 5½" diameter concrete monument with G.L.O. brass cap. Corner was recorded in Liber 7, Page 80.

B. Description of corner evidence found and/or method applied in restoring or reestablishing corner:
 (A-7) This corner is being perpetuated as part of the Chippewa County Remonumentation program.

Found 5½" diameter concrete monument with G.L.O. brass cap as previously described along with many witnesses. Accepted corner position as found.

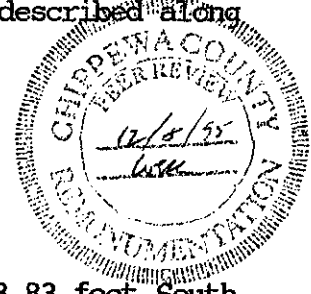

C. Description of monument for corner and accessories established to perpetuate locating the position of the corner:
 (A-7) Corner is a 5½" diameter concrete monument with G.L.O. brass cap 63.83 feet South of centerline and 3.0 feet East of centerline of Irish Line Road.

Witnesses:

3/4" Pipe w/Pk Nail	S75°W	0.38'
Southerly Lip of SW Cor Conc Culvert	N62°W	29.02'
Guy Pole	S30°W	68.50'
Power Pole	N13°E	136.48'
NW Cor Black Building	S27°E	97.44'
Power Pole	S19°E	66.95'



Signed by William L. Karr
 Surveyor's Michigan License No. 27450

Date 12/13/95

NOTE: Bearings are compass bearings corrected for declination. Distances are to a nail in side of witness objects unless noted. FORM APPROVED BY MICHIGAN STATE BOARD OF PROFESSIONAL SURVEYORS, JAN. 28, 1971 REVISIED MAY 14, 1975 REVISIED JAN. 1983 REVISIED OCT., 1985