

APR 07 1998

LAND CORNER RECORDATION CERTIFICATE  
Filing Requirement of Act 74, Mich. P.A. 1970  
Chippewa County Remonumentation Corner

For corners in

Chippewa

Located In:

Corner Code #

1. Public Land Survey

T 46N R 2W

T 46N R 3W

T \_\_\_ R \_\_\_

T \_\_\_ R \_\_\_

2. Property Controlling  
in Section

S \_\_\_ T \_\_\_ R \_\_\_

S \_\_\_ T \_\_\_ R \_\_\_

3. Miscellaneous  
Property in Sec.

S \_\_\_ T \_\_\_ R \_\_\_

S \_\_\_ T \_\_\_ R \_\_\_

A-10 Same  
M-10 Corner

\$7.00 LAND CORNER SECTION

\$2.00 MSSR

12 Mar 1998 12:37:32 PM Receipt #

RECEIVED FOR RECORD

CHIPPENNA COUNTY - STATE OF MICHIGAN  
SHARON H. KENNEDY, REGISTER OF DEED

BOOK 10 PAGE 214

Register of Deeds Stamp & File Number

4. Lot No. \_\_\_\_\_, Recorded Plat \_\_\_\_\_

5. Private Claims \_\_\_\_\_

I, William L. Karr, in a field survey on November 3, 1997, do hereby state that under requirements of P.A. 74, Michigan P.A. of 1970, the corner points mentioned in lines 1 and 2 above were in conformance with regulations and rules therefore as required in the current manual of survey instructions of the United States Department of the Interior, Bureau of Land Management or by a decree of a Court of Law and/or that the corner points mentioned in lines 3, 4 and 5 above were in conformance with the rules of the Michigan Board of Land Surveyors or by a Decree of a Court of Law; established, re-established, monumented, recovered, found as expressed below

NOTE: Not more than 2 corners, all in the same town and range, may be recorded on this certificate.

1	A	B	C	D	E	F	G	H	I	J	K	L	M
2		6		5		4		3		2		1	
3													
4		7				9		10		11		12	
5													
6		18		17				15		14		13	
7													
8		19		20		21		22		23		24	
9													
10		30		29		28		27		26		25	
11													
12		31		32		33		34		35		36	
13													

A. Description of original monument and accessories and/or subsequent restoration:

(A-10) 1/4 Corner Common to Section 30, T.46 N., R.2 W., and Section 25, T.46 N., R.3 W.

1840 Austin Burt, D.S. set post in original survey. Witnesses: Maple 14 S79°W 29  
Maple 7 N38°W 19

1995 Ron Bischer, P.S. 22428, found a bolt with 1 1/2" head and established (4) witnesses.

B. Description of corner evidence found and/or method applied in restoring or reestablishing corner:

(A-10) 1/4 Corner Common to Section 30, T.46 N., R.2 W., and Section 25, T.46 N., R.3 W.

This corner is being perpetuated as part of the Chippewa County Remonumentation Program.


Found no evidence of the original corner. Found bolt and (3) of Bischer's witnesses. Distance North to Section corner 19, 30, 25 and 24 is 2631.02'; distance South to Section corner 30, 31, 36 and 25 is 2640.40'. Accepted corner position as found and established (1) new witness.

C. Description of monument for corner and accessories established to perpetuate locating the position of the corner:

(A-10) 1/4 Corner Common to Section 30, T.46 N., R.2 W., and Section 25, T.46 N., R.3 W.

Corner is a 1" x 1" square bolt, 10" below grade and is 3'± East of centerline of North-South Two Track.

Witnesses: Maple 6" N52°E 41.29' (existing tag)  
Aspen 16" S63°E 18.61' (existing tag)  
W. Birch 6" (double) S31°W 52.95'  
(West trunk)  
Maple (multiple) N50°W 49.03' (existing tag)

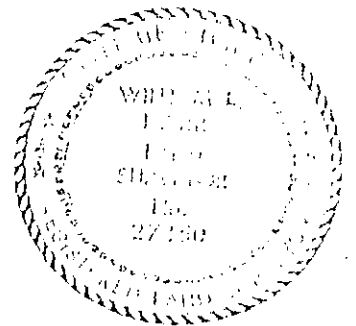

Signed by William L. Karr Date 12/29/97

Surveyor's Michigan License No. 27450

NOTE: All bearings are compass bearings corrected for declination (6°W). All distances are to a nail and tag in the side of witness object unless otherwise noted.