

APR 07 1998

LAND CORNER RECORDATION CERTIFICATE
Filing Requirement of Act 74, Mich. P.A. 1970
Chippewa County Remonumentation Corner

SECTION

For corners in

Chippewa

Located In:

Corner Code #

1. Public Land Survey

T 46N R 2W
T 46N R 3W

A-12 Same
M-12 Corner

2. Property Controlling in Section

S T R
S T R

3. Miscellaneous Property in Sec.

S T R
S T R

\$7.00 LAND CORNER

\$2.00 MSSR

12 Mar 1998 12:38:30 PM Receipt #6

RECEIVED FOR RECORD

CHIPPWEA COUNTY - STATE OF MICHIGAN
SHARON H. KENNEDY, REGISTER OF DEEDS

BOOK 10 PAGE 216

Register of Deeds Stamp & File Number

4. Lot No. Recorded Plat

5. Private Claims

I, William L. Karr, in a field survey on November 3, 1997, do hereby state that under requirements of P.A. 74, Michigan P.A. of 1970, the corner points mentioned in lines 1 and 2 above were in conformance with regulations and rules therefore as required in the current manual of survey instructions of the United States Department of the Interior, Bureau of Land Management or by a decree of a Court of Law and/or that the corner points mentioned in lines 3, 4 and 5 above were in conformance with the rules of the Michigan Board of Land Surveyors or by a Decree of a Court of Law; established, re-established, monumented, recovered, found as expressed below:

NOTE: Not more than 2 corners, all in the same town and range, may be recorded on this certificate.

Grid table with columns A-M and rows 1-13. Includes handwritten annotations 'T46N' and 'R2W'.

A. Description of original monument and accessories and/or subsequent restoration:

(A-12) 1/4 Corner Common to Section 31, T.46 N., R.2 W., and Section 36, T.46 N., R.3 W.

1840 Austin Burt, D.S. set post in original survey. Witnesses: Fir 6 S72°W 23 Birch 6 N73°W 25

Found no record of subsequent restoration.



B. Description of corner evidence found and/or method applied in restoring or reestablishing corner:

(A-12) 1/4 Corner Common to Section 31, T.46 N., R.2 W., and Section 36, T.46 N., R.3 W.

This corner is being perpetuated as part of the Chippewa County Remonumentation Program.


Found no evidence of the original corner or subsequent restoration. Reestablished corner by single proportionate measurement (mid-way and on-line) between Section corner 30, 31, 25 and 36 and the Township corner 31, 6, 1 and 36. Distance North and South is 2634.40'.

C. Description of monument for corner and accessories established to perpetuate locating the position of the corner:

(A-12) 1/4 Corner Common to Section 31, T.46 N., R.2 W., and Section 36, T.46 N., R.3 W.

Corner is a 3/4" x 24" iron with stamped aluminum Chippewa County Remonumentation Corner cap and falls in a tag alder swamp.

Witnesses: Aspen 6" N10°E 51.50'
Aspen 11" N79°E 71.98'
Aspen 10" S36°W 64.50'
Balsam 8" N64°W 79.71'

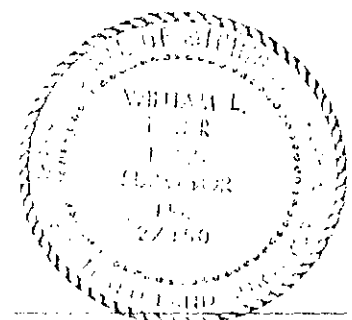

Signed by [Signature]

Date 12/29/97

Surveyor's Michigan License No. 27450

NOTE: All bearings are compass bearings corrected for declination (6°W). All distances are to a nail and tag in the side of witness object unless otherwise noted.