

SURVEY & REMONUMENTATION

DEC 09 1993

CHIPPEWA COUNTY REMONUMENTATION CORNER

RECEIVED FOR RECORD
CHIPPEWA COUNTY
STATE OF MICHIGAN

LAND CORNER RECORDATION CERTIFICATE

Filing Requirement of Act 74, Mich. P.A. 1970

93 DEC -3 PM 3:58

For corners in CHIPPEWA
(County)

Located In:

Corner Code #

- | | | |
|------------------------------------|--------------------------|-------------------|
| 1. Public Land Survey | T <u>47N</u> R <u>1E</u> | <u>A-2</u> Same |
| | T <u>47N</u> R <u>1W</u> | <u>M-2</u> Corner |
| | T _____ R _____ | _____ |
| | T _____ R _____ | _____ |
| 2. Property Controlling in Section | S _____ T _____ R _____ | _____ |
| | S _____ T _____ R _____ | _____ |
| 3. Miscellaneous Property in Sec. | S _____ T _____ R _____ | _____ |
| | -S _____ T _____ R _____ | _____ |
4. Lot No. _____, Recorded Plat _____
5. Private Claims _____

J. Roger Malott
REGISTER OF DEEDS

Register of Deeds Stamp & File Number

I, Keith R. Waters in a field survey on October 28, 19 93, do hereby certify that under requirements of P.A. 74, Michigan P.A. of 1970, the corner points mentioned in lines 1 and 2 above were in conformance with regulations and rules therefore as required in the current manual of survey instructions of the United States Department of the Interior, Bureau of Land Management or by a decree of a Court of Law and/or that the corner points mentioned in lines 3, 4 and 5 above were in conformance with the rules of the Michigan Board of Land Surveyors or by a Decree of a Court of Law; established, re-established, monumented, re-monumented, recovered, found as expressed below:

NOTE: Not more than 4 corners, all in the same town and range, may be recorded on this certificate.

A. Description of original monument and accessories and/or subsequent restoration:

A-2 (T47N, R1E)
1/4 Corner Common to Section 6, T47N, R1E & Section 1, T47N, R1W.

This corner is recorded in liber 1, page 193, of Chippewa County corner records (1976), by James H. Granger, P.S. 16041, as a PK nail with the following witnesses: Power Pole (A-19/34), S80°W 50.96'
Guy Pole (760B5), S77°30'E 31.73'
Guy Pole (704B3), S38°W 70.33'

B. Description of corner evidence found and/or method applied in restoring or reestablishing corner:


A-2 (T47N, R1E)
This corner is being perpetuated as part of the Chippewa County Remonumentation Program.
Found a 1/2" iron with plastic cap #27450 in centerline of north-south asphalt road (Meridian Street) at the north right-of-way line of Spruce Street. Position checks fairly well with two remaining poles as shown on Granger records. (No measuring nails were found in poles). Accepted corner as found and established new witness objects.

C. Description of monument for corner and accessories established to perpetuate locating the position of the corner:

A-2 (T47N, R1E)
Corner is a 1/2" iron with plastic cap #27450 in the centerline of Spruce Street on the north right-of-way line of Spruce Street.

- Witnesses:
- Power Pole (760-B5), N75°W 32.18'
 - Power Pole (A19-34), S74°E 51.23'
 - Nail/tag in Top of Northerly Guard Rail Post, S29°E 92.95'
 - Iron w/cap #27450, SOUTH 33.00'
 - Power Pole, (A19-35), N23°E 113.20'

Note: Distances to poles are to a nail and tag in the side. Bearings are compass bearings corrected for declination.

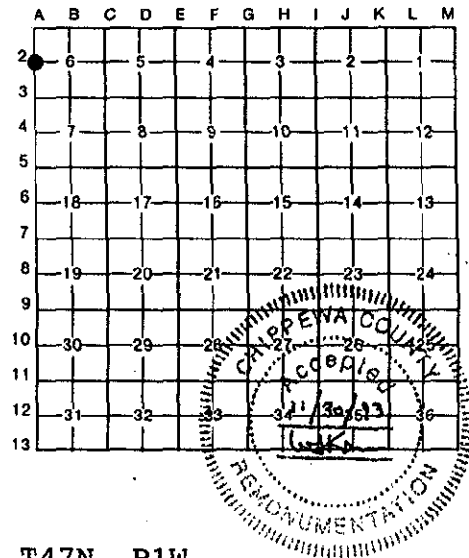

Signed by Keith R. Waters Date 11-30-93

Surveyor's Michigan License No. 33142