

SURVEY & REMONUMENTATION

CHIPPEWA COUNTY REMONUMENTATION CORNER

RECEIVED FOR RECORD
CHIPPEWA COUNTY
STATE OF MICHIGAN

DEC 09 1993

LAND CORNER RECORDATION CERTIFICATE
Filing Requirement of Act 74, Mich. P.A. 1970

93 DEC -3 PM 3:59

For corners in
Chippewa
(County)

Located In:	Corner Code #
T47N R1E	A-3 Same
T47N R1W	M-3 Corner
T _____ R _____	_____
T _____ R _____	_____
S _____ T _____ R _____	_____
S _____ T _____ R _____	_____
S _____ T _____ R _____	_____


J. Roger Malott
REGISTER OF DEEDS

Register of Deeds Stamp & File Number

4. Lot No. _____, Recorded Plat _____
5. Private Claims _____

I, Keith R. Waters, in a field survey on June 9, 1993, do hereby certify that under requirements of P.A. 74, Michigan P.A. of 1970, the corner points mentioned in lines 1 and 2 above were in conformance with regulations and rules therefore as required in the current manual of survey instructions of the United States Department of the Interior, Bureau of Land Management or by a decree of a Court of Law and/or that the corner points mentioned in lines 3, 4 and 5 above were in conformance with the rules of the Michigan Board of Land Surveyors or by a Decree of a Court of Law; established, re-established, monumented, re-monumented, recovered, found as expressed below:

NOTE: Not more than 4 corners, all in the same town and range, may be recorded on this certificate.

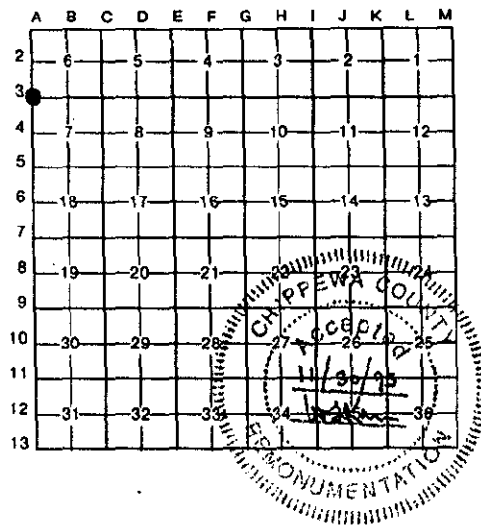

A. Description of original monument and accessories and/or subsequent restoration:

A-3 (T47N, R1E)
Section Corner Common to Sections 6 & 7, T47N, R1E and Sections 1 & 12, T47N, R1W.

This corner is recorded by James H. Granger, P.S. 16041, in liber 1, page 249, of Chippewa County corner records (1977) as a bolt in a monument box 3.8' north of centerline of east-west road with the following ties:
SW Bldg Cor, N30°E 82.82' Util. Pole, S50°W 53.25' Hydrant, N40°W 50.15'

B. Description of corner evidence found and/or method applied in restoring or reestablishing corner:

A-3 (T47N, R1E)
This corner is being perpetuated as part of the Chippewa County Remonumentation Program.
Found a bolt in a monument box 3.8' north of centerline of Easterday Avenue. Hydrant and utility pole from Granger records are gone. Tie to corner of building (Brady Hall) checks well. Accepted corner as found and established four new witness objects.



C. Description of monument for corner and accessories established to perpetuate locating the position of the corner:

A-3 (T47N, R1E)
Corner is a bolt in a monument box 3.8' north of centerline of Easterday Avenue at intersection of Meridian Street to the south.

Witnesses:
Center of Top Bolt on Hydrant, N55°W 62.11'
Traffic Signal Pole, N51°E 44.06'
Light Pole, S20°E 57.02'
Chiseled "X" in S.E. Corner of Concrete Steam Access Structure, N46°W 81.70'

Note: Unless noted otherwise, distances to a nail and tag in the side of the witness object. Bearings are compass bearings corrected for declination. Distances measured with EDM.

Signed by Keith R. Waters Date 11-30-93

Surveyor's Michigan License No. 33142