

SURVEY & REMONUMENTATION

DEC 09 1993

CHIPPEWA COUNTY REMONUMENTATION CORNER
CHIPPEWA COUNTY
STATE OF MICHIGAN

LAND CORNER RECORDATION CERTIFICATE
Filing Requirement of Act 74, Mich. P.A. 1970

93 DEC -3 PM 3:58

COMMISSION

For corners in
Chippewa
(County)

Located In: Corner Code #


- | | | |
|---------------------------------------|--------------------------|-------------------|
| 1. Public Land Survey | T <u>47N</u> R <u>1E</u> | <u>A-5</u> Same |
| | T <u>47N</u> R <u>1W</u> | <u>M-5</u> Corner |
| | T _____ R _____ | _____ |
| | T _____ R _____ | _____ |
| 2. Property Controlling in Section | S _____ T _____ R _____ | _____ |
| | S _____ T _____ R _____ | _____ |
| 3. Miscellaneous Property in Sec. | S _____ T _____ R _____ | _____ |
| | *S _____ T _____ R _____ | _____ |
| 4. Lot No. _____, Recorded Plat _____ | | |
| 5. Private Claims _____ | | |

J. Roger Malott
REGISTER OF DEEDS

Register of Deeds Stamp & File Number

I, Keith R. Waters in a field survey on November 3, 19 93, do hereby certify that under requirements of P.A. 74, Michigan P.A. of 1970, the corner points mentioned in lines 1 and 2 above were in conformance with regulations and rules therefore as required in the current manual of survey instructions of the United States Department of the Interior, Bureau of Land Management or by a decree of a Court of Law and/or that the corner points mentioned in lines 3, 4 and 5 above were in conformance with the rules of the Michigan Board of Land Surveyors or by a Decree of a Court of Law; established, re-established, monumented, re-monumented, recovered, found as expressed below:

NOTE: Not more than 4 corners, all in the same town and range, may be recorded on this certificate.

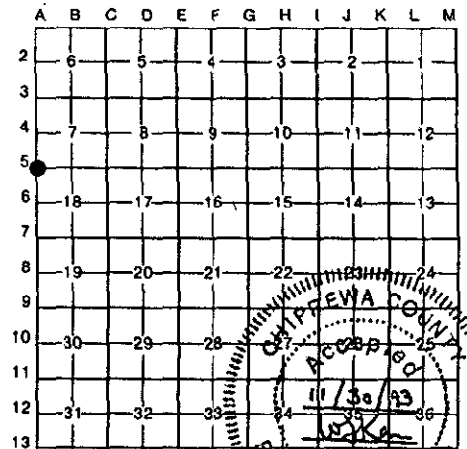


A. Description of original monument and accessories and/or subsequent restoration:

A-5 (T47N, R1E)
Section Corner Common to Secs. 7 & 18, T47N, R1E & Secs. 12 & 13, T47N, R1W.
Corner is recorded in liber 2, page 248, by Michigan Dept. of State Highways, as a set 3/8" copper clad rod between main N-S runway and unimproved runway.

Corner subsequently recorded in liber 1, page 248, by James H. Granger, P.S. 16041 (1977), as a found 3/8" rod between main N-S runway and unimproved runway, with no witnesses shown.

B. Description of corner evidence found and/or method applied in restoring or reestablishing corner:

A-5 (T47N, R1E)
This corner is being perpetuated as part of the Chippewa County Remonumentation Program.
Found a 3/8" iron rod between main north-south runway and north-south unimproved runway. Position checks with surveys done in the area. Accepted corner as found, replaced 3/8" rod with a 3/4" x 24" rebar with a 3 1/4" aluminum Chippewa County Remonumentation cap.

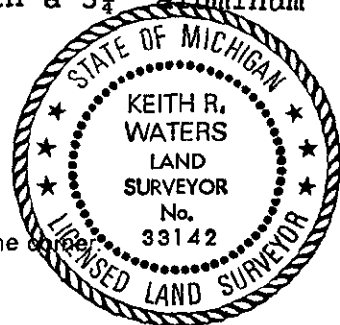

C. Description of monument for corner and accessories established to perpetuate locating the position of the corner:

A-5 (T47N, R1E)
Corner is a 3/4" x 24" rebar with a 3 1/4" aluminum Chippewa County Remonumentation cap 300'± northeasterly of centerline of main runway.
Witnesses:

- Center of base of runway light, S65°W 253.02'
- Center of base of runway light, S21°W 270.38'
- Center of wind velocity pole, N70°E 392.36'
- Northwesterly bolt (no nut) in concrete base for wind sock tower, N53°E 582.08'

Note: Bearings are compass bearings corrected for declination.

Signed by Keith R. Waters Date 11-30-93

Surveyor's Michigan License No. 33142